


T. 5S., R. 1W., W.M.

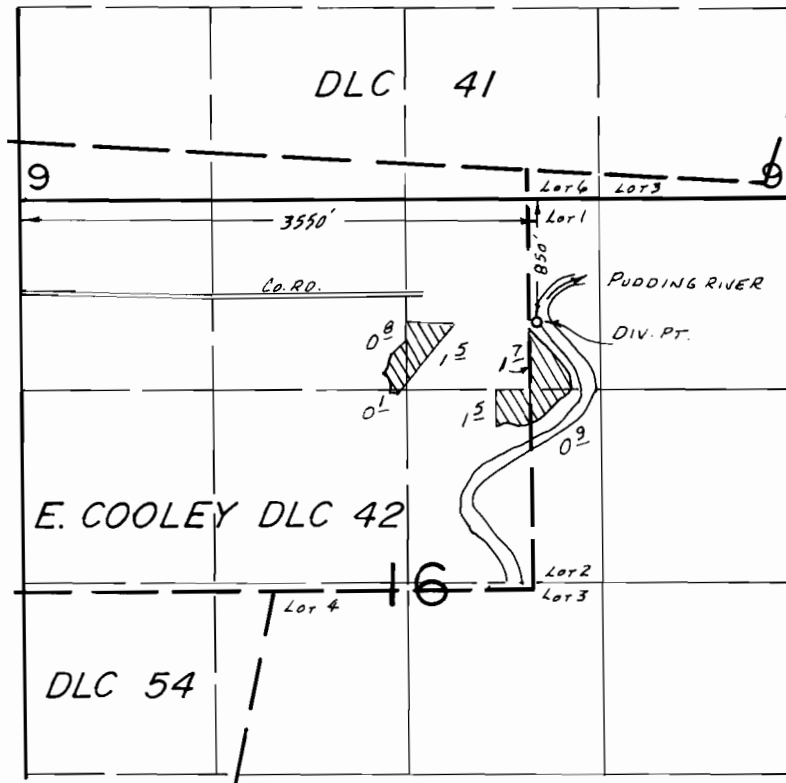

SCALE: 1" = 1320'

**FINAL PROOF SURVEY**  
UNDER

Application No. 52314... Permit No. 39351.....  
IN NAME OF

.....EARL A. DOMAN.....

Surveyed Mar. 27... 1986, by T.M. WARREN...

4/11/86  
EWB