


T.8S., R.3W., W.M.

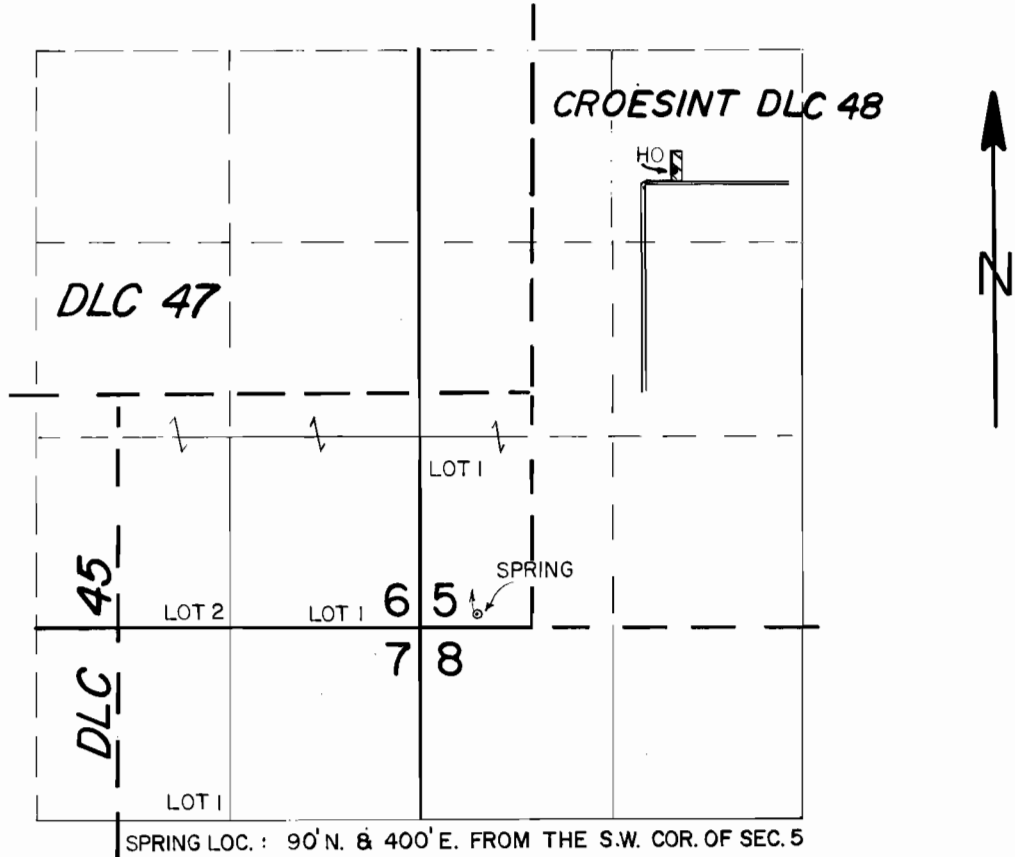

SCALE : 1" = 1320'

FINAL PROOF SURVEY
UNDER

Application No. 63252... Permit No. 46711.....

IN NAME OF

MARGARET H. SCOTT

Surveyed MAY 28, 19 85, by T.W. WARREN...