


T. 7 S., R. 2 W., W.M.

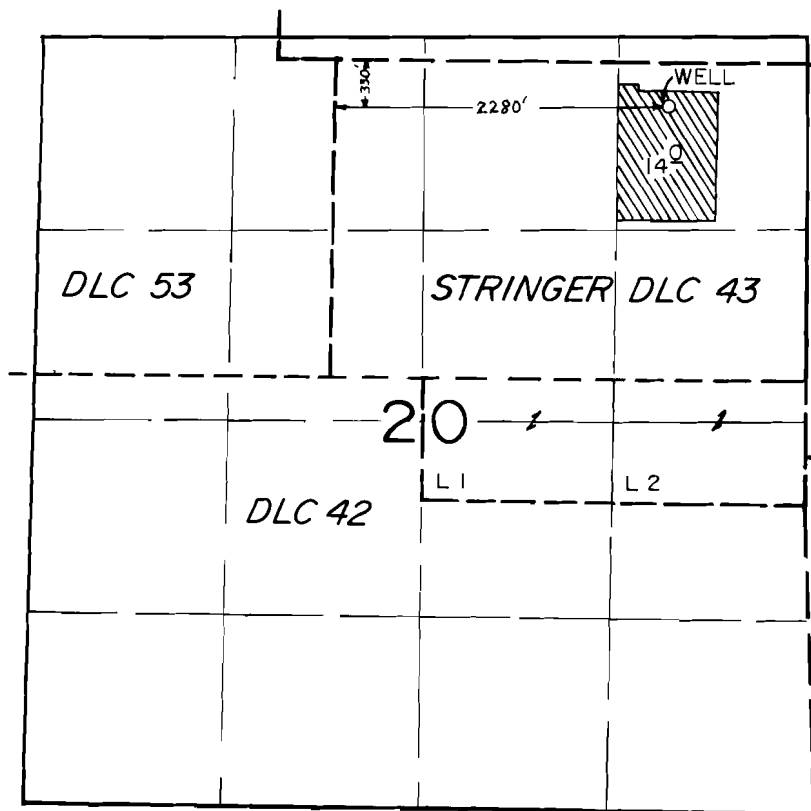

SCALE: 1" = 1320'

**FINAL PROOF SURVEY**  
UNDER

Application No. G-5383 Permit No. G-5314.....

IN NAME OF

ART PARMELEE

Surveyed APRIL 16, 1986, by T. M. WARREN.....