


T.4S.,R.IW.,W.M.

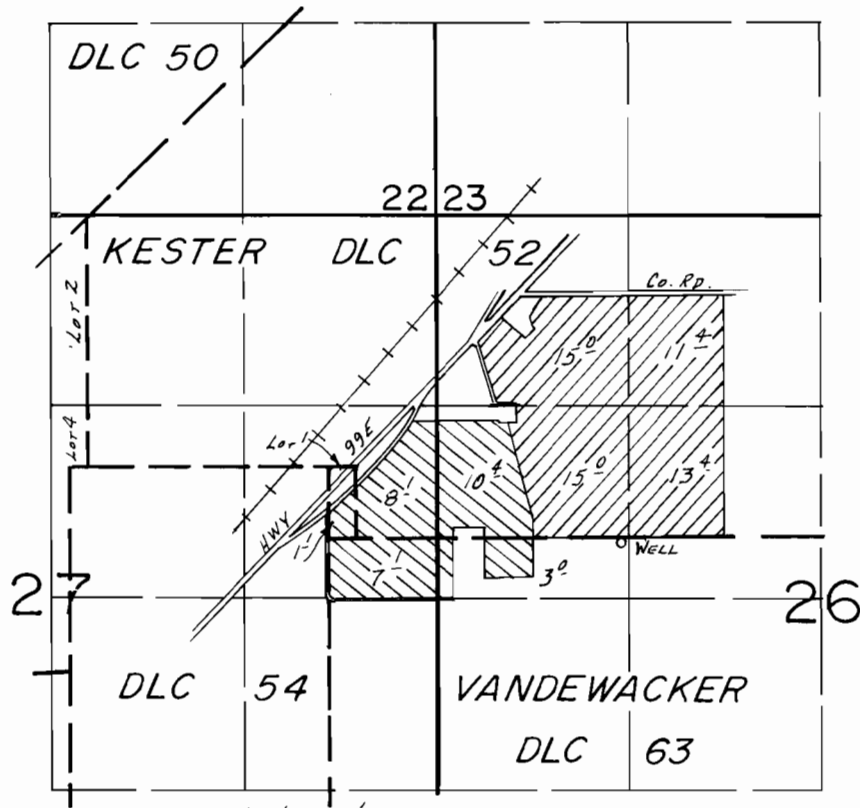

WELL LOC.: 40'S. & 2020'E. FROM NW COR. VANDEWACKER DLC 63

-  PRIMARY
-  SUPPLEMENTAL

SCALE: 1" = 1320'

FINAL PROOF SURVEY UNDER

Application No. G.:8774. Permit No. G.:8085....
IN NAME OF

.....STAUFFER BROS.....

Surveyed Oct., 27, 1983, by L. M. TOLL.....

5/2/86
BWB