




T. 7 S., R. 1 W., W.M.

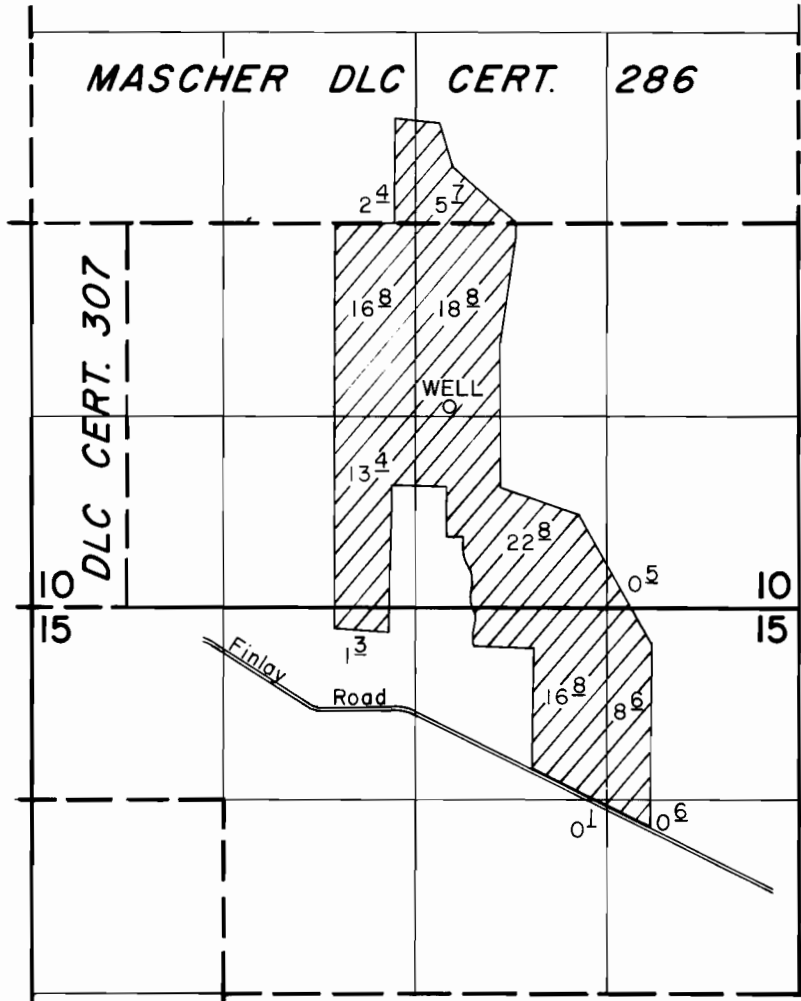

WELL LOC: 1400' N. & 230' E. FROM S1/4 CORNER SECTION 10

SCALE: 1" = 1320'

FINAL PROOF SURVEY
UNDER

Application No. G-10696 Permit No. G-9788
IN NAME OF

ARTHUR ENDRESEN

Surveyed AUG. 15. 1985, by B. W. BISHOP