


T. 8 S., R. 1 W., W.M.

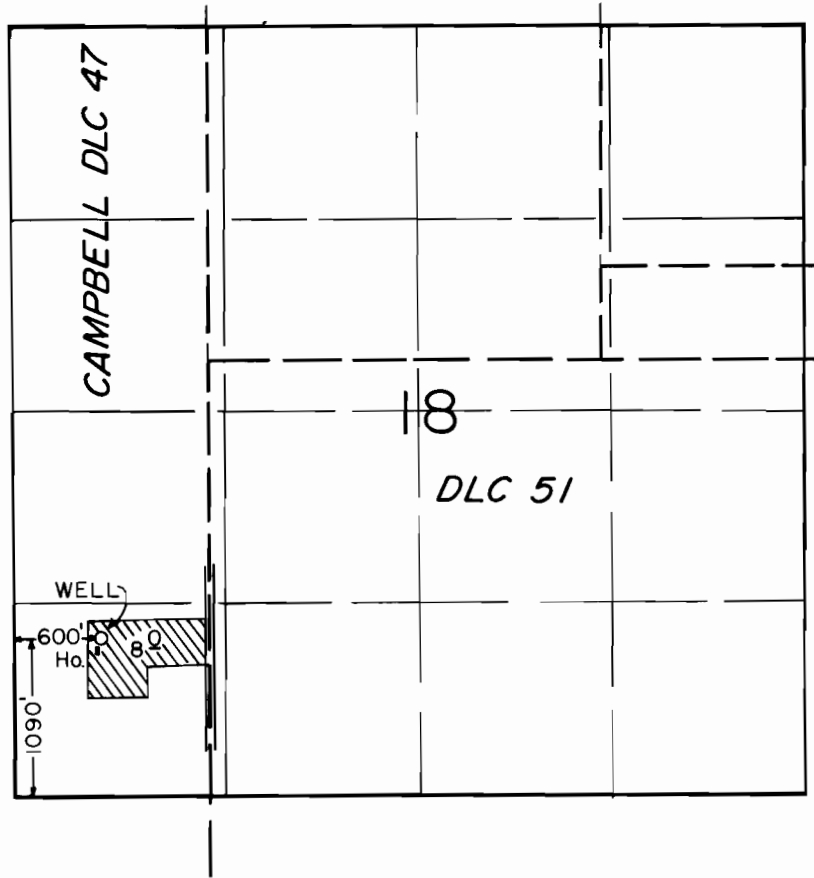

SCALE: 1" = 1320'

**FINAL PROOF SURVEY**  
UNDER

Application No. G-10713 Permit No. G-9793

IN NAME OF

CHARLES R. WHITE

Surveyed APRIL 24 1986, by T. M. WARREN