


T.6S.,R.2W.,W.M.

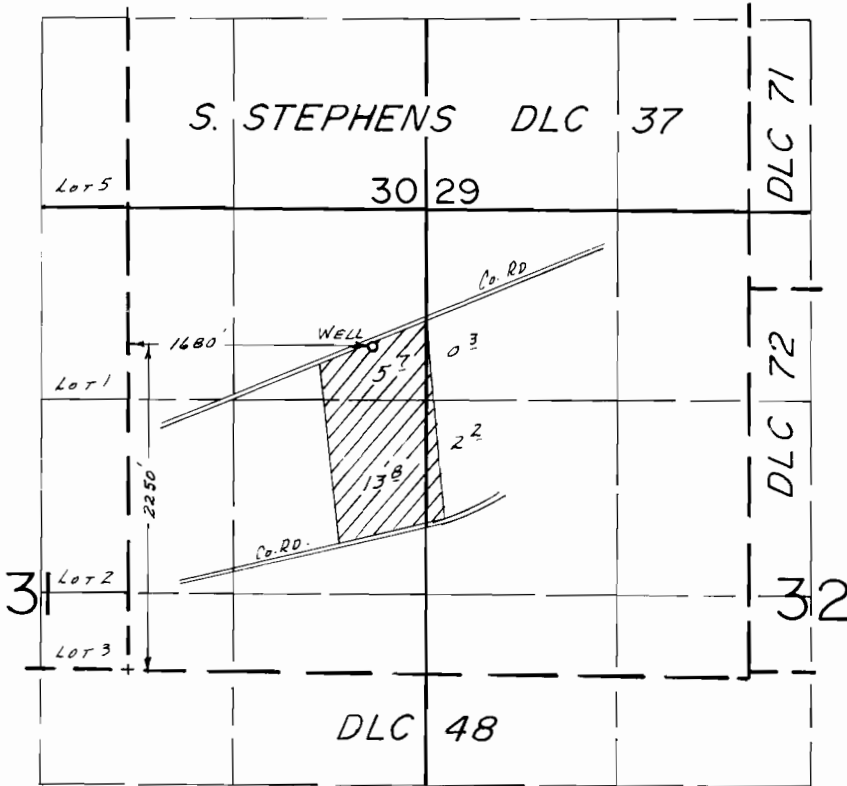

SCALE: 1" = 1320'

**FINAL PROOF SURVEY**  
UNDER

Application No. G.:113.48. Permit No. G.:104.78...  
IN NAME OF

.....  
W. JAMES PFAU  
.....

Surveyed Apr. 4..... 1986, by T.M. WARREN....

4/24/86  
JWB

DFN-1P-29