
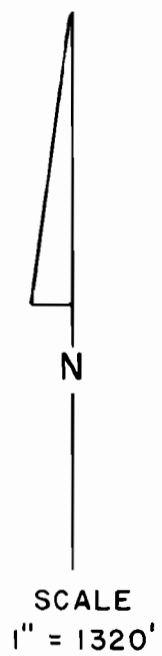


T. 2 S., R. 10 W., W.M.

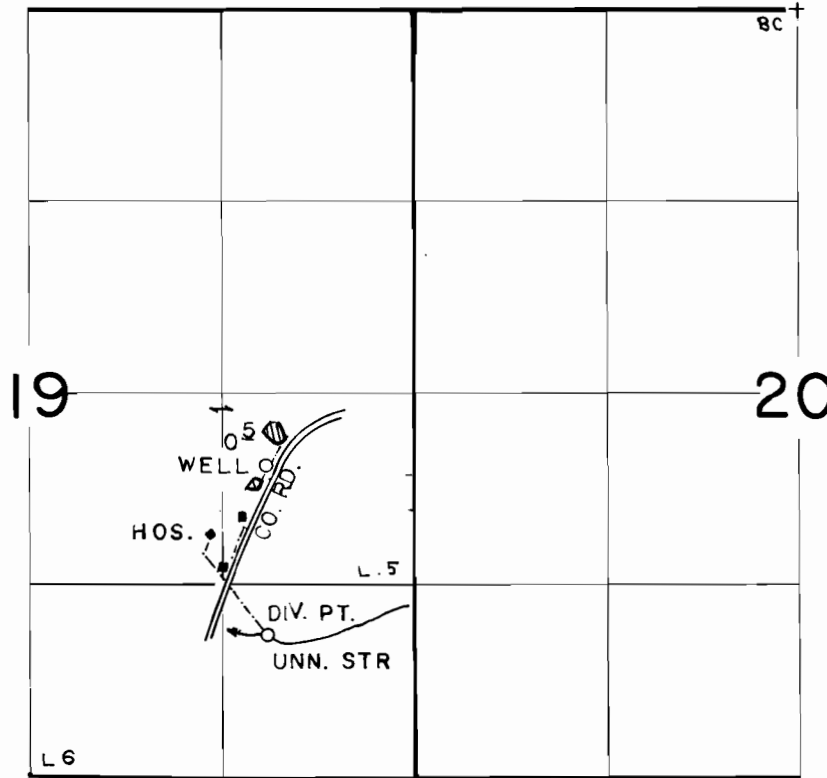

WELL LOC. 2150' N & 1020' W. OF SE COR. SEC. 19
 DIV. PT. LOC. 970' N. & 1020' W OF SE COR. SEC 19

FINAL PROOF SURVEY UNDER

Application No. 60994 G9302 G8640
 Permit No. 45338.....

IN NAME OF

JOHN L. CARLICH

Surveyed JUL 31 1984, by P. PAGTER.....