


T. 2 S., R. 2 W., W.M.

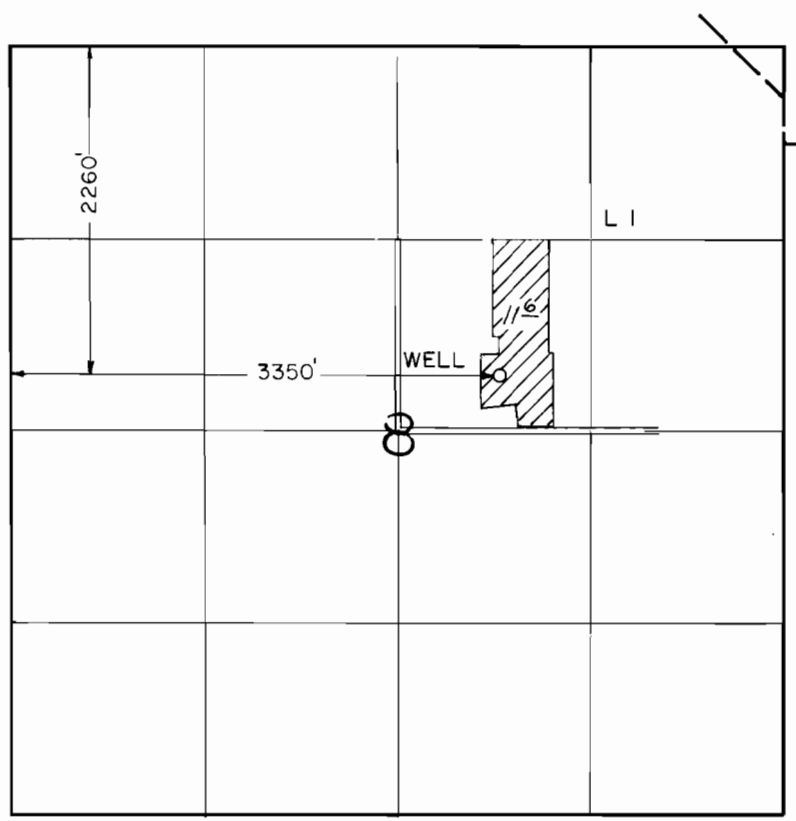

SCALE: 1" = 1320'

FINAL PROOF SURVEY
UNDER

Application No. G-9363 Permit No. G-9589
IN NAME OF

GLENN A. WALTERS

Surveyed AUG. 13, 1985, by T.M. WARREN