


T. 2 S., R. 2 W., W.M.

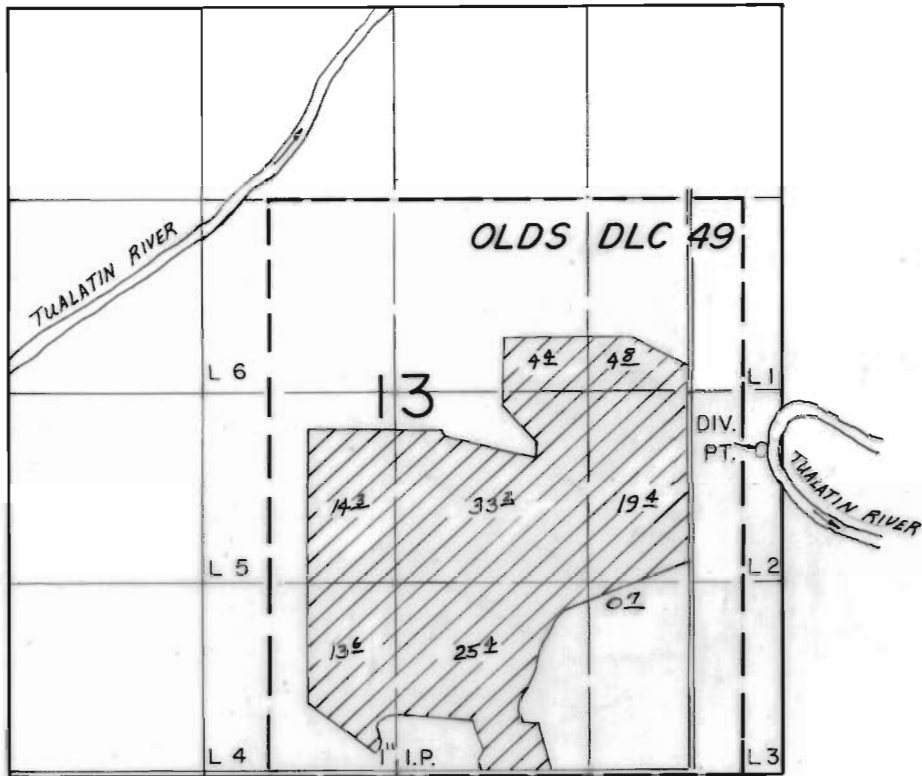

DIV. PT. LOC: 2220' N. AND 140' W. FROM THE S.E. COR. SEC. 13.

SCALE: 1" = 1320'

**FINAL PROOF SURVEY**  
UNDER

Application No. 50947 Permit No. 38460  
IN NAME OF

**WILLIAM SHEPPARD & BERTHA A. ROTH**

Surveyed JULY 29, 1985, by T.M. WARREN.