


# T. 1N., R. 4W., W.M.

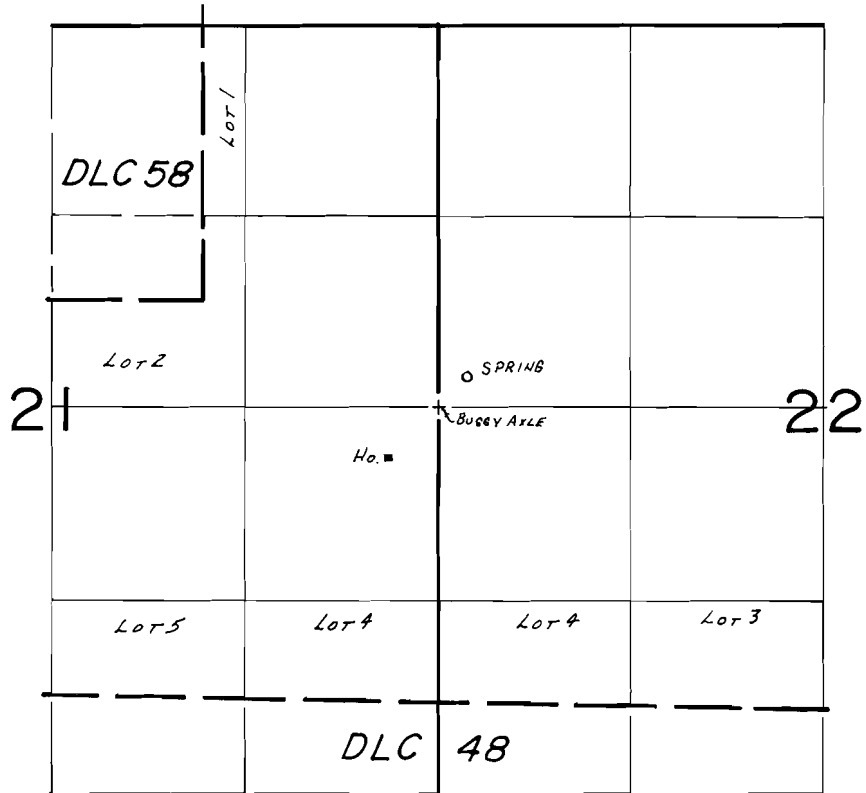

SPRING LOCATED 200' N. & 200' E. FROM W. 1/4 COR. SEC. 22

SCALE: 1" = 1320'

## FINAL PROOF SURVEY UNDER

Application No. 59865 Permit No. 45285.....  
IN NAME OF

.....JOYCE F. JENSEN.....

Surveyed Aug. 21, 1984, by B.W. BISHOP.....