


T.29S., R.12 W., W.M.

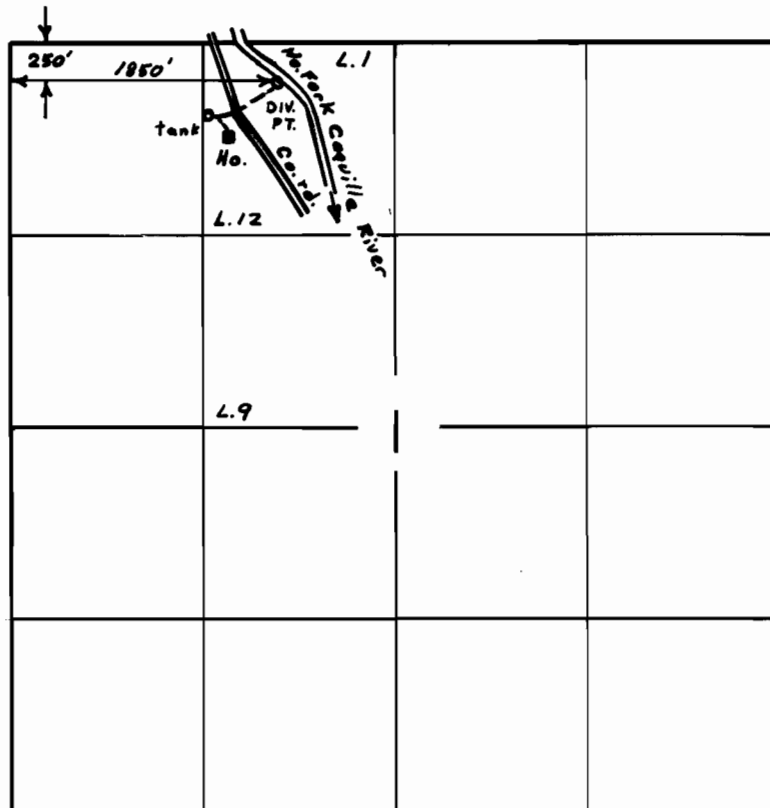

SCALE : 4" = 1 mile

FINAL PROOF SURVEY UNDER

Application No. 49232. Permit No. 36901....
IN NAME OF

.....
Surveyed .9.-27. 1979, by S. DONALDSON