


T. 28 S. R. 7 W. WM

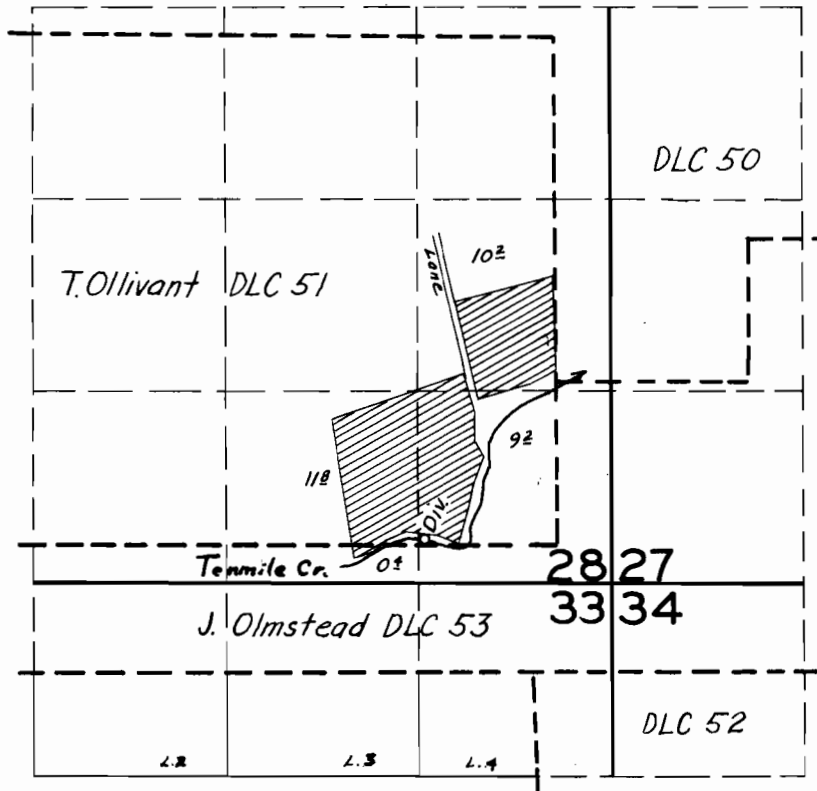

FINAL PROOF SURVEY UNDER

Application No. 2005 Permit No. 15222
IN NAME OF

James Stackhouse

Surveyed July 23, 1901, by J. Jones