


# T.30S.R.6W.W.M.

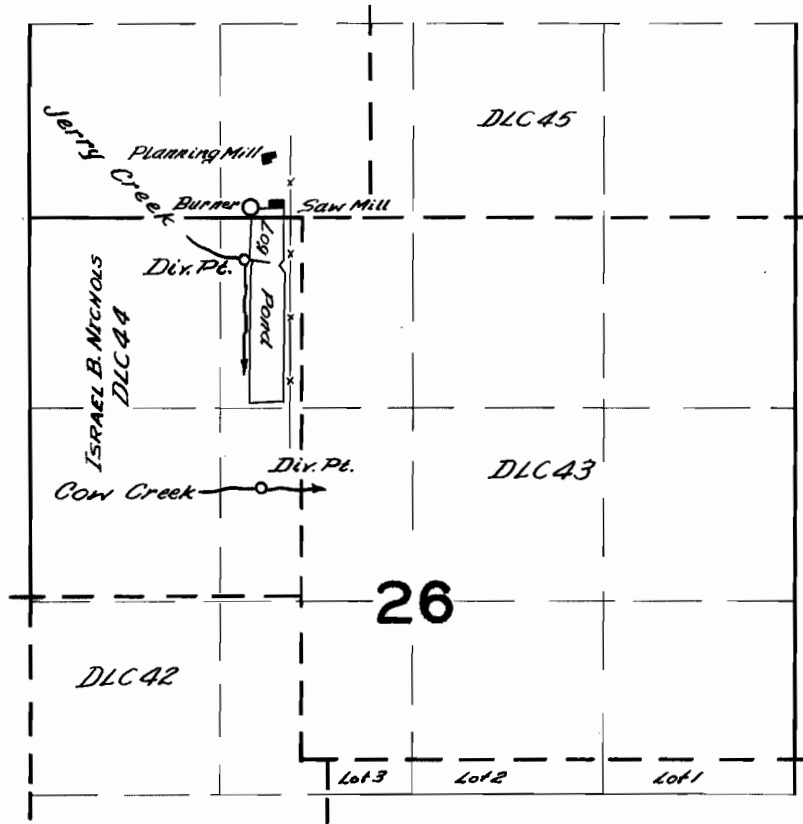

## FINAL PROOF SURVEY UNDER

Application No. R-25560 25561 Permit No. R-1146 20225  
IN NAME OF

PATRICK LUMBER Co.

Surveyed April 12, 1957, by C. C. Burtis