


T.24S.R.5W.W.M.

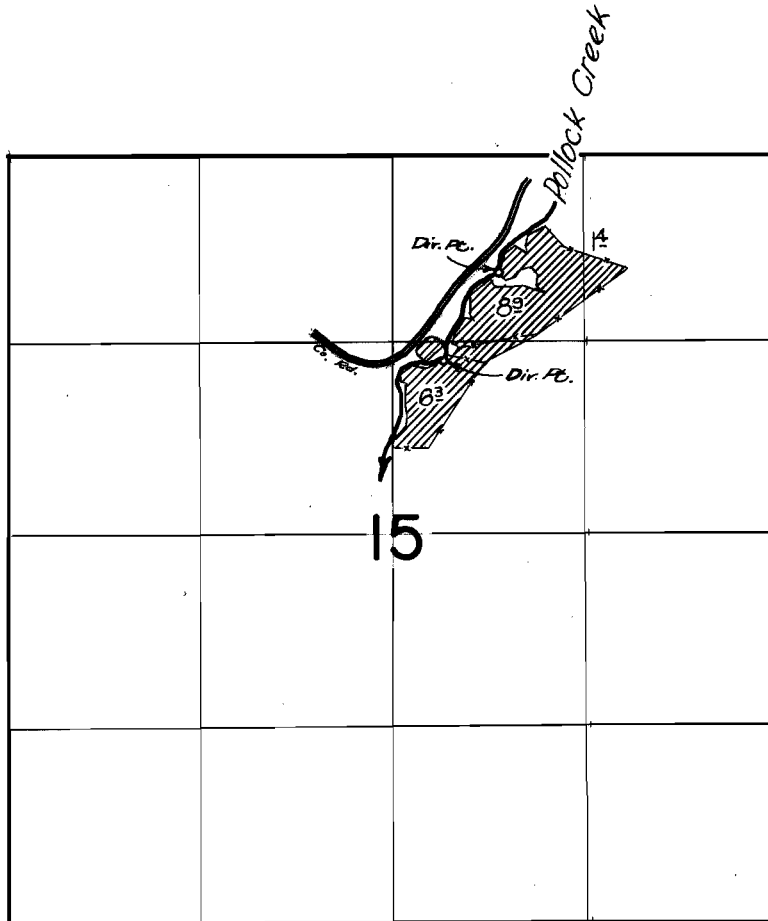


**FINAL PROOF SURVEY**  
UNDER

Application No. 32814 Permit No. 25938  
IN NAME OF

DONNE NERELL

Surveyed June 7 1965, by A. Jackson

T.24S.R.5W.W.M.

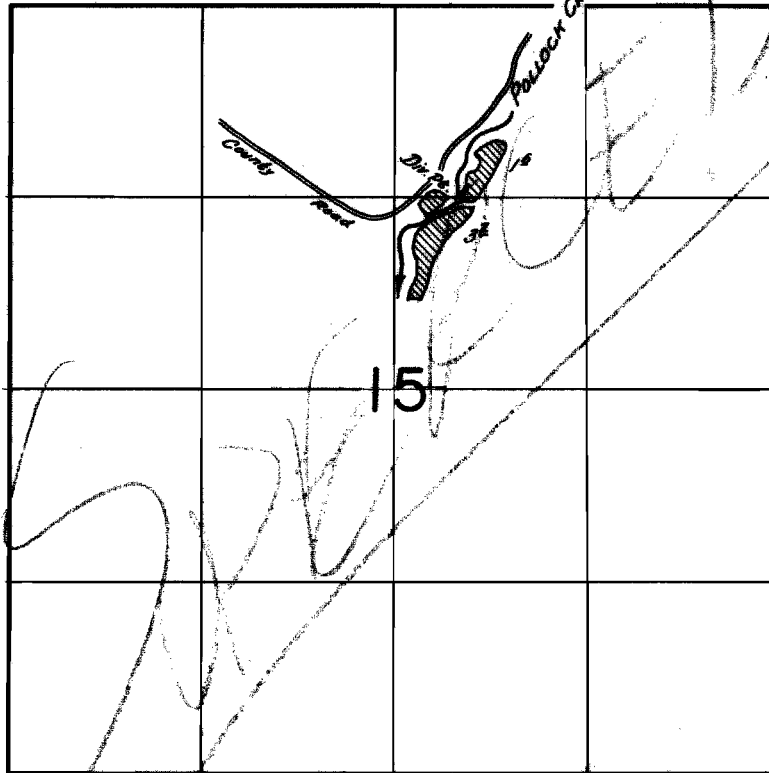

**FINAL PROOF SURVEY**  
UNDER

Application No. 32814 Permit No. 25938  
IN NAME OF

Donne Nerell

Surveyed April 10 1963, by C.O. Bartels