


T.38 S., R.3 W., W.M.

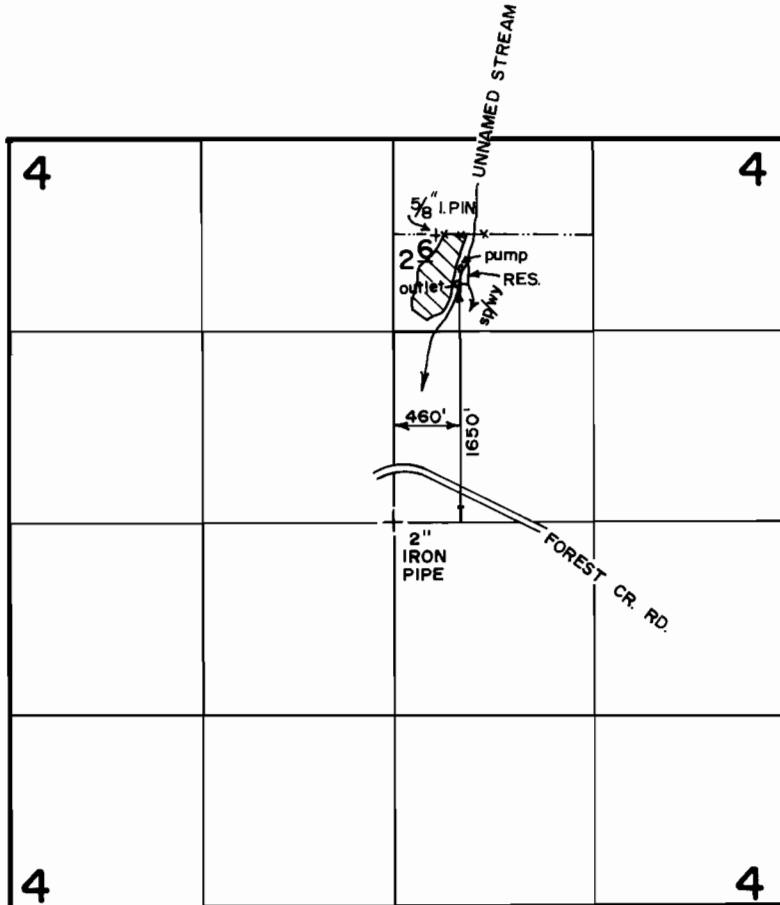

FINAL PROOF SURVEY
UNDER

R-52302 R-6297
Application No. 52303... Permit No. 39346.....
IN NAME OF

..KAREN...S...MITCHELL.....

Surveyed April..23, 1982., by B.R..SUND.....

SCALE : 4" = 1 Mile