


T.38 S., R.3 W., W.M.

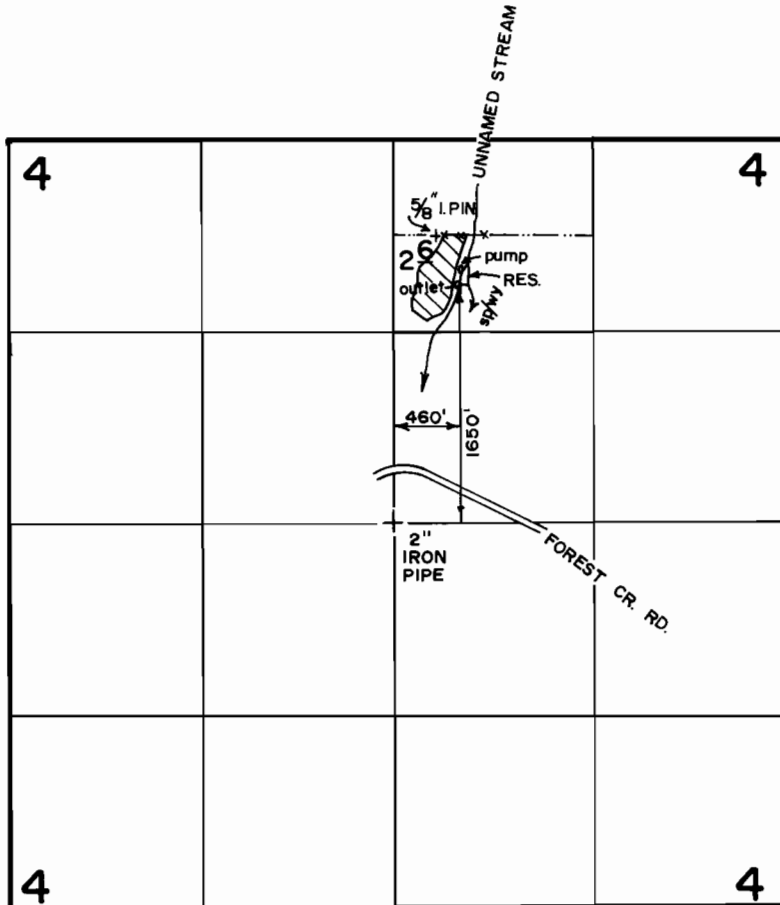

**FINAL PROOF SURVEY**  
UNDER

R-52302 R-6297  
Application No. 52303 Permit No. 39346.....  
IN NAME OF

..KAREN S. MITCHELL.....

Surveyed April 23, 1982., by B.R. SUND.....

SCALE : 4" = 1 Mile