


T. 35 S., R. 3 W., W.M.

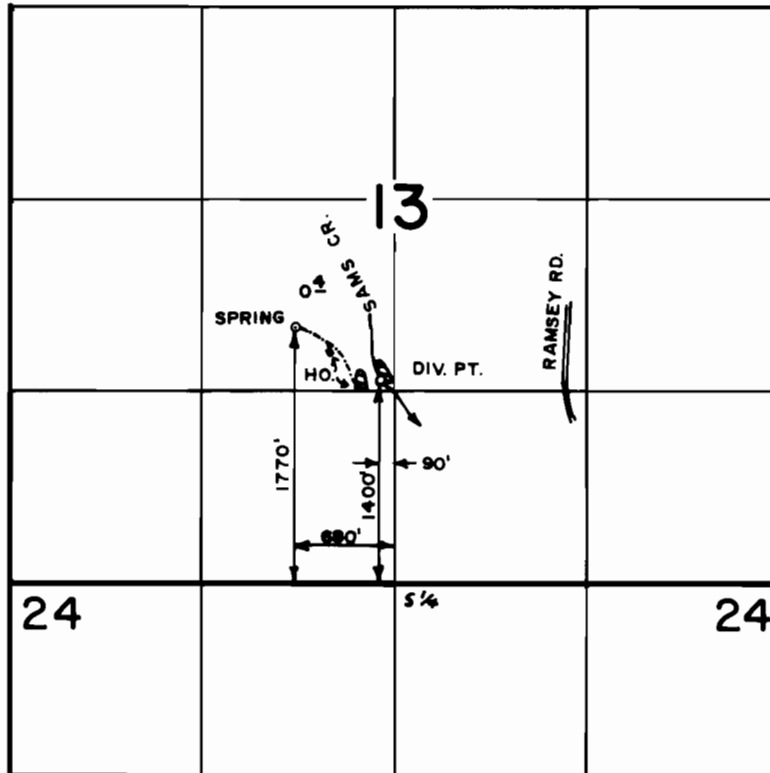

FINAL PROOF SURVEY
UNDER

Application No. 50710 Permit No. 38300....
IN NAME OF

.....DON & or SALLY HERMAN.....

Surveyed JULY 23, 1982, by B.S. JAMES.....

Scale: 4" = 1 Mile