


T. 38 S., R. 3 W., W.M.

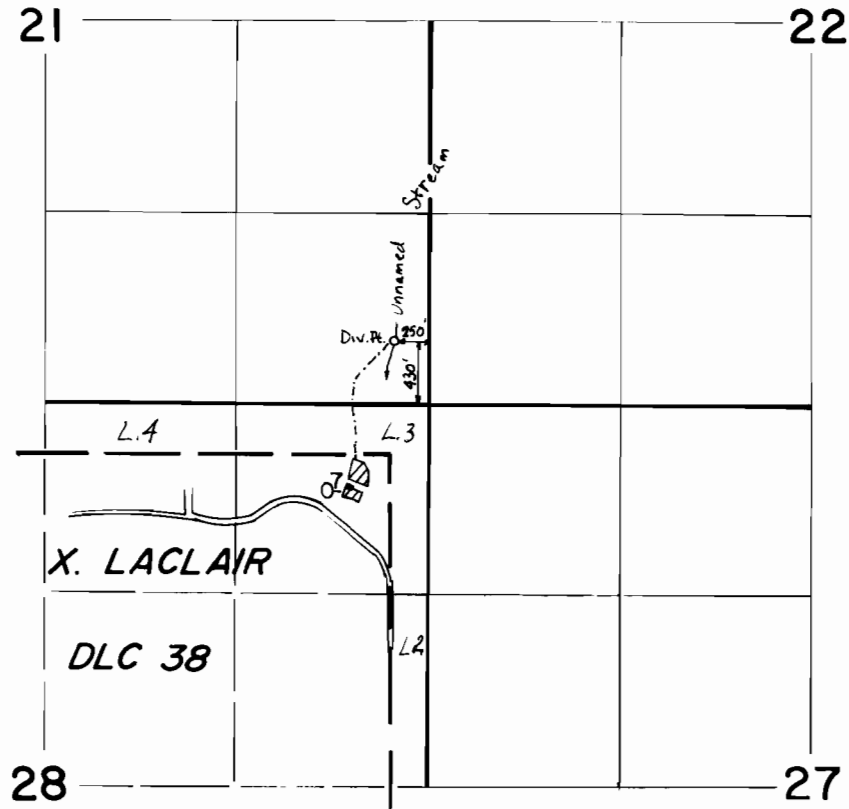

FINAL PROOF SURVEY
UNDER

Application No. 51638 Permit No. 38939
IN NAME OF

JOHN J. LUND

Surveyed APRIL 20, 1982, by B. R. SUND