


T. 38 S., R. 3 W., W.M.

SEC. 4

SW 1/4 NE 1/4

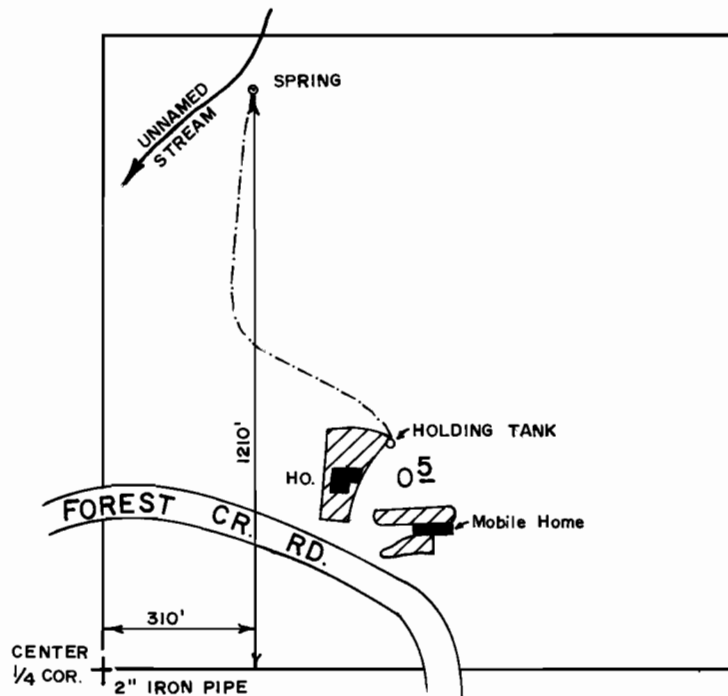

**FINAL PROOF SURVEY**  
UNDER

Application No. 53212.. Permit No. 39486.....  
IN NAME OF

**BERNARD K. &/or WINIFRED H. KNUTSEN**

Surveyed April 23, 1982., by B.R. SUND.....

SCALE : 1" = 400'