


T.39S., R.3W., W.M.

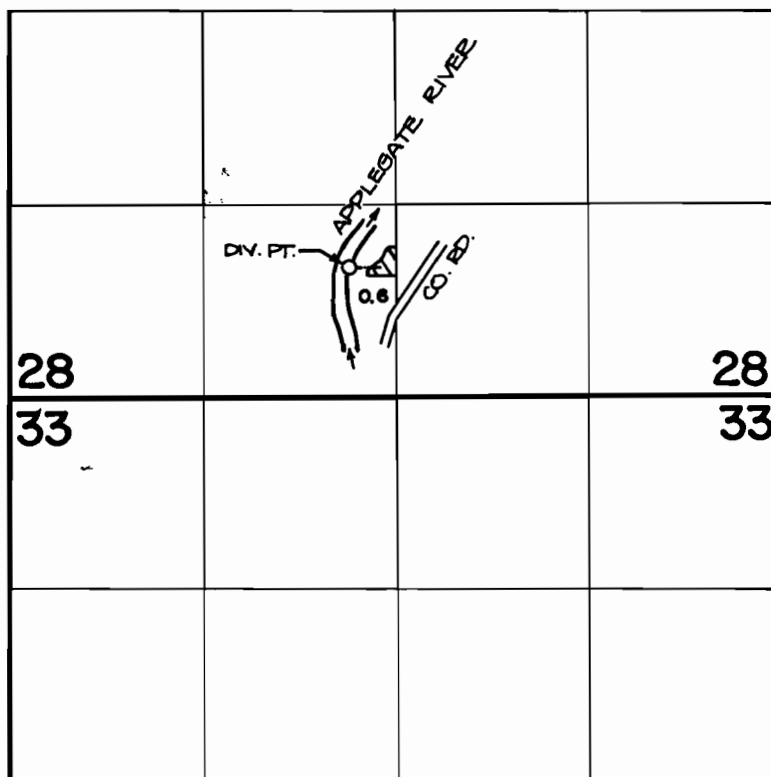

DIVERSION POINT IS LOCATED 690' N. AND 320' W. FROM THE S. 1/4 CORNER OF SECTION 28.

FINAL PROOF SURVEY UNDER

Application No. 52555... Permit No. 39652.....
IN NAME OF

BONNAR W. AND/OR DOLORES J. DYSART

Surveyed MAY..6.... 1982., by .B...SUND.....