


T. 34 S., R. 1 W., W.M.  
SEC. 15

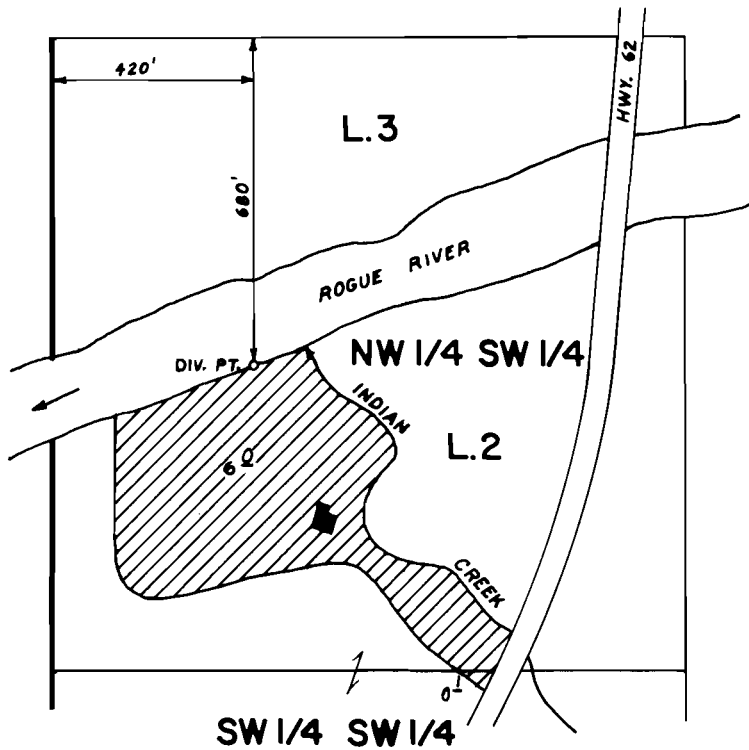

SCALE: 1" = 400'

**FINAL PROOF SURVEY**  
UNDER

Application No. 52185 Permit No. 40700  
IN NAME OF

JAMES D. ROBERTS

Surveyed NOV. 4, 1982, by B.S. JAMES