


T. 32 S., R. 3 E., W. M.

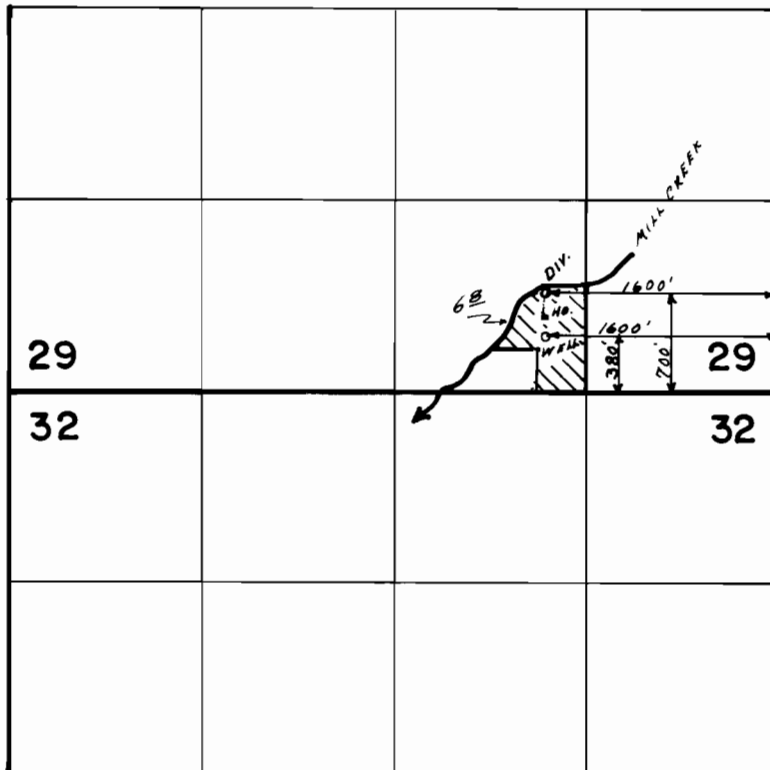

SCALE: 1" = 1320'

FINAL PROOF SURVEY
UNDER

57648

43424

Application No. G-9271 Permit No. G-8735
IN NAME OF

RICHARD F. & MARILYN L. SCHAFFRAN

Surveyed OCT. 29 1985, by B. S. JAMES.