


T.38S.,R.4W.,W.M.

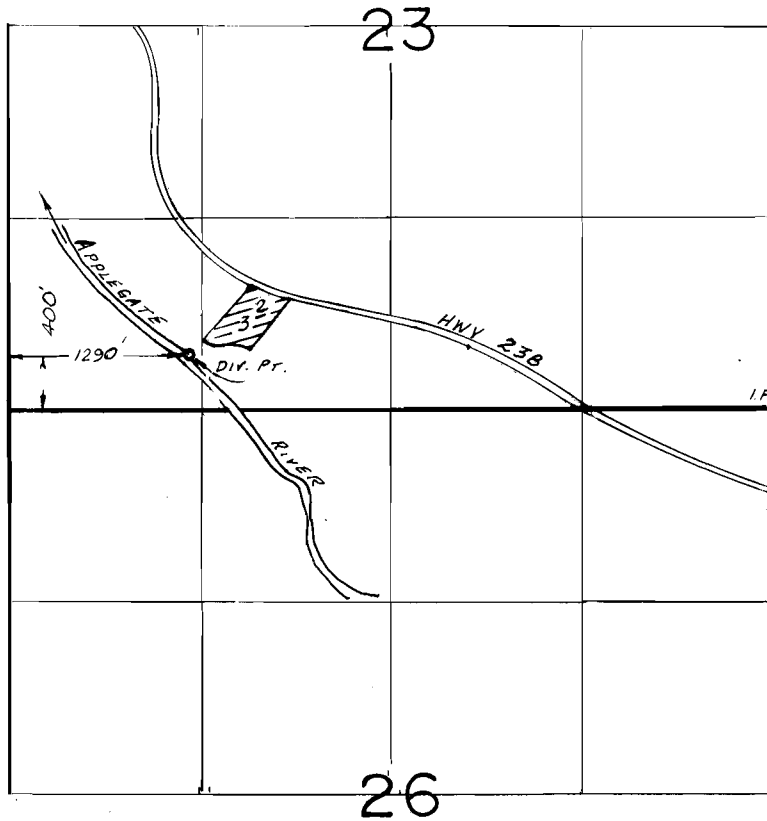

SCALE: 1" = 1320'

**FINAL PROOF SURVEY**  
UNDER

Application No. 63777... Permit No. 46999.....  
IN NAME OF

.....DAVID T. KNIGHT.....

Surveyed Aug. 27... 19.85., by B.S. JAMES.....