


T.39 & 40S., R.3W., W.M.

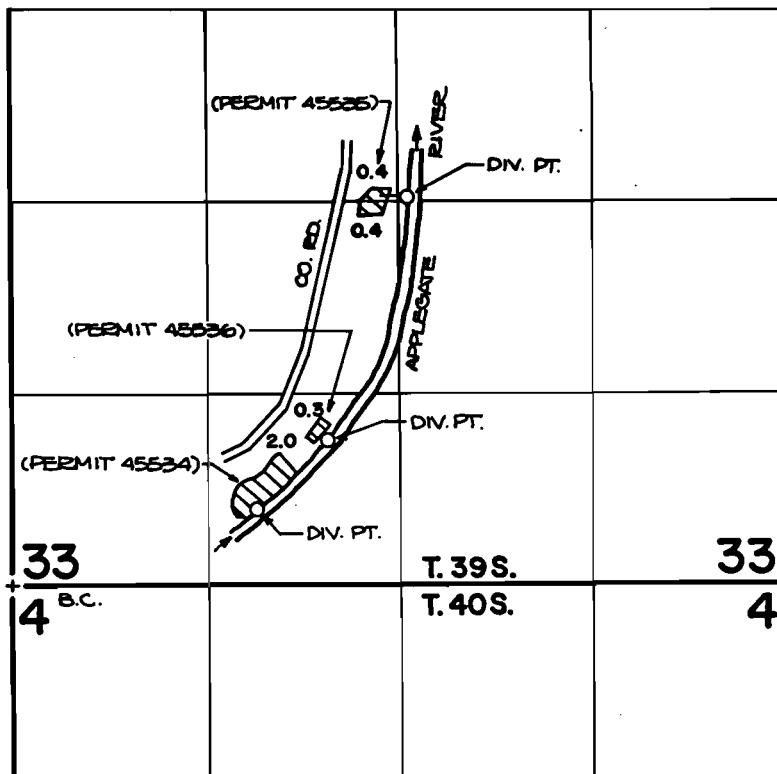

DIV. PT. (PERMIT 45525) LOC: 2640' N. AND 2690' E.;
 DIV. PT. (PERMIT 45536) LOC: 990' N. AND 2140' E.;
 DIV. PT. (PERMIT 45534) LOC: 510' N. AND 1660' E.;
 ALL FROM THE S.W. CORNER OF SECTION 33.

FINAL PROOF SURVEY UNDER

60447 45536
 60446 45535
 Application No. 60305. Permit No. 45534.....
 IN NAME OF

LEE & MARGARET MYERS
 Joseph R. & Glenice Nashlund
 Surveyed MAY 18 1982, by B. SUND.....