


T.38S. R.4W. W.M.

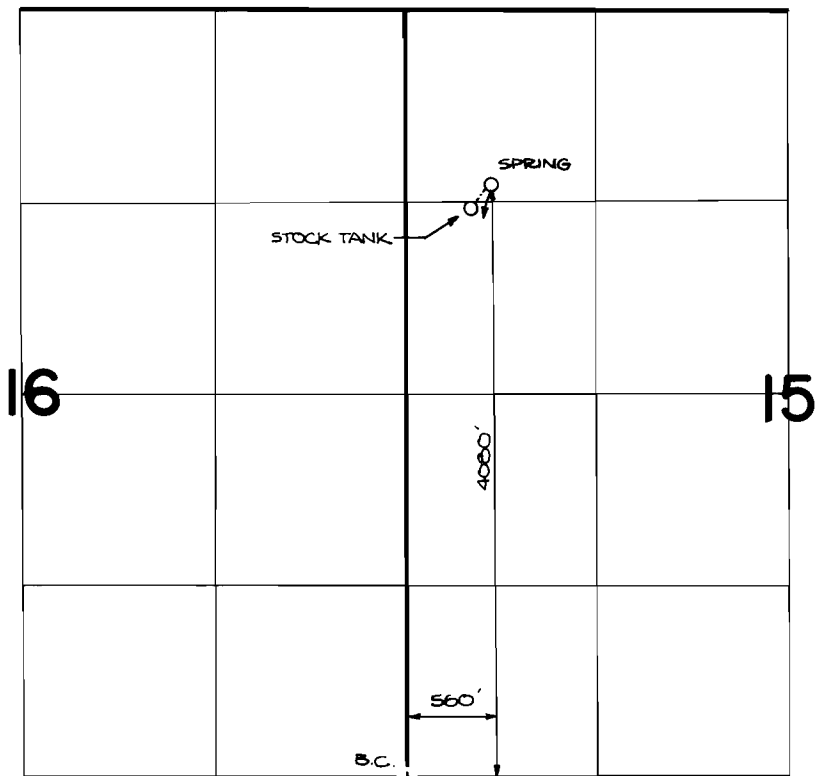

FINAL PROOF SURVEY UNDER

Application No. **61563** Permit No. **45765**
IN NAME OF

BUREAU OF LAND MANAGEMENT

Surveyed **MAY 26**, 19**82**, by **B. SUND**