


RECEIVED

T.38S., R.3W., W.M.

AUG 4 1981

WATER RESOURCES DEPT.
SALEM, OREGON

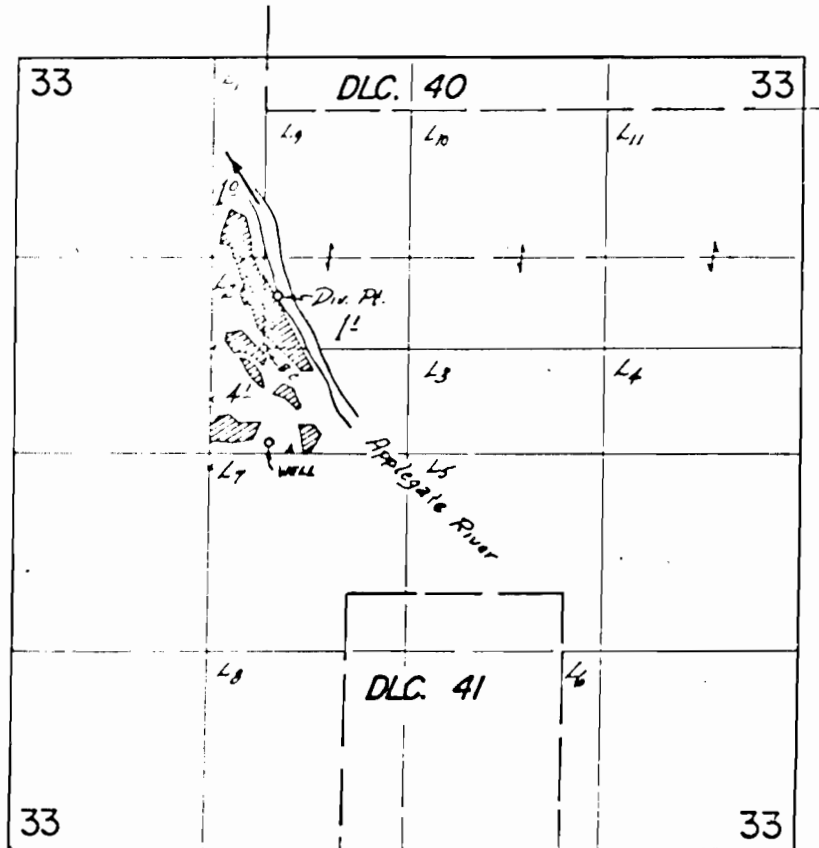

Div Pts loc: River - 350' N of 80' E; Well - 630' S of 10' E, both from SW cor Lot 9 Sec 33.

Appl 61807
PER. 45882

~~FINAL PROOF SURVEY~~
UNDER

Application No. ~~42700~~ ~~G-4505~~ Permit No. ~~31905~~ ~~G-4247~~
IN NAME OF

~~Jackson County Parks & Recreation~~

Surveyed ~~Oct 16~~ 19 ~~73~~, by ~~D. Nixey~~