


Application No. 62145
Permit No. 45963

T. 40 S. R. 3 W. W. M.

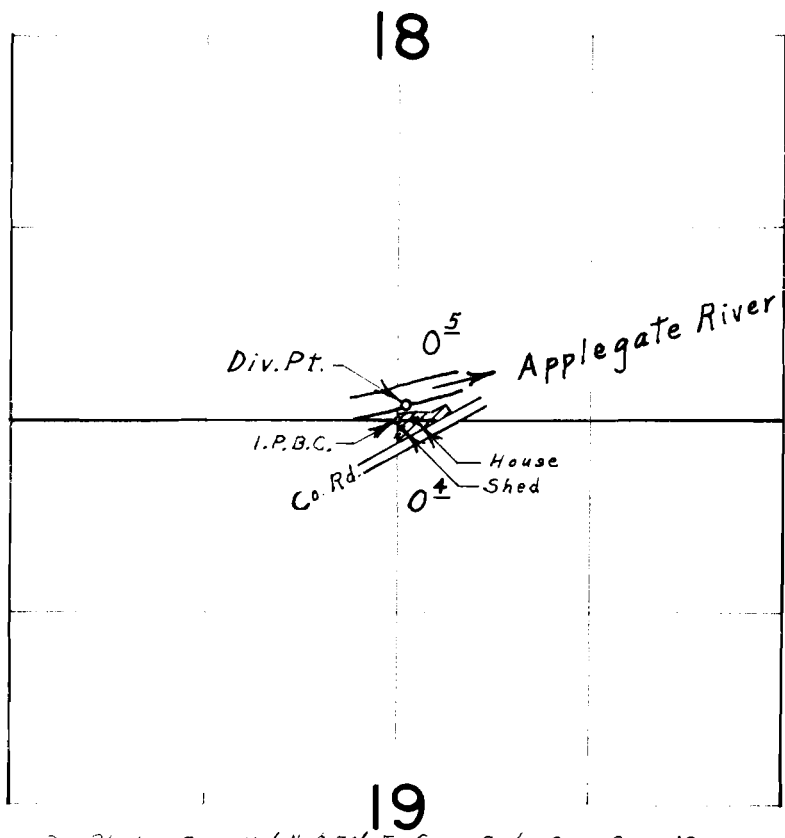

Div. Pt. locates 110' N. & 70' E. from S. $\frac{1}{4}$ Cor. Sec. 18

FINAL PROOF SURVEY
UNDER

Application No. 44928 Permit No. 33579
IN NAME OF

ARDITH E. LEWIS

Surveyed Sept. 18, 1971, by L. E. Gould

*Copied 8-31-81
see remarks
section of appl.
DAB.*