


T. 35 S., R. 2 W., W.M.

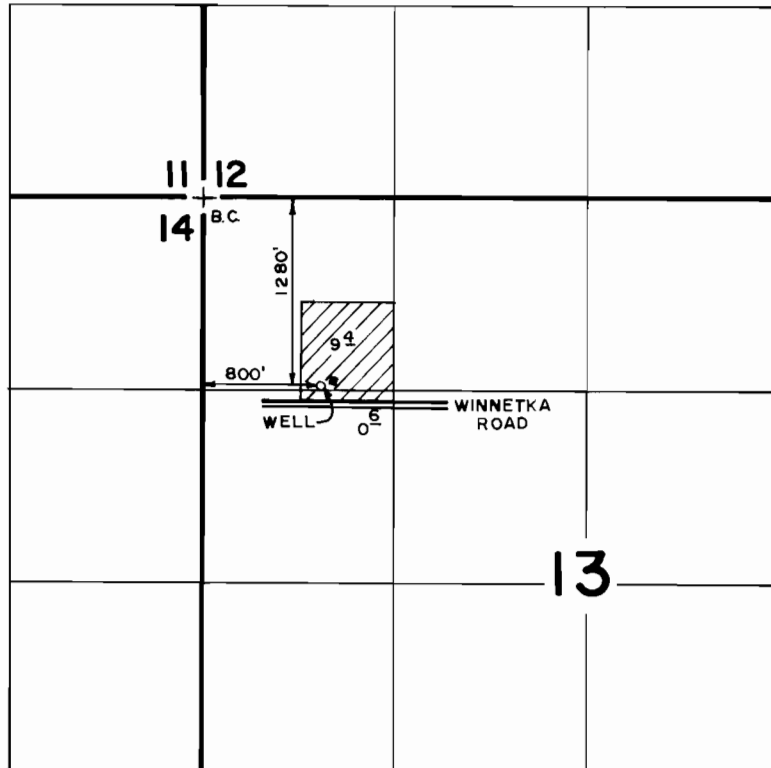

FINAL PROOF SURVEY
UNDER

Application No. **G-6484** Permit No. **G-6104**
IN NAME OF

DAVID G. &/or NANCY L. GREEN

Surveyed **JULY 14, 1982**, by **R. SUZIE JAMES**.

SCALE: 4" = 1 MILE