


T.38S., R.4W., W.M.

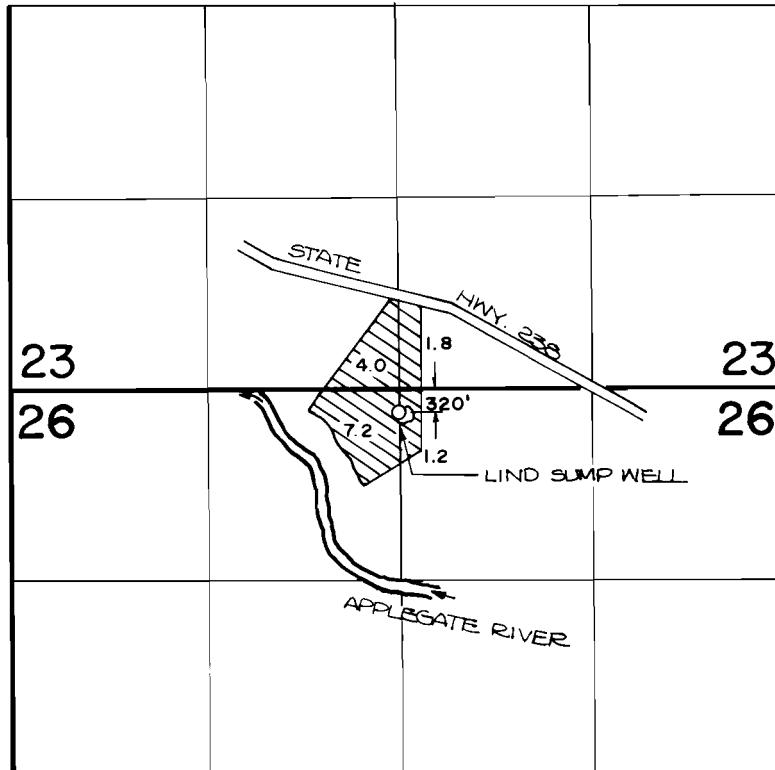

FINAL PROOF SURVEY
UNDER

Application No. G-7620 Permit No. G-7066...
IN NAME OF

.....CHESTER LIND.....

Surveyed APR. 1, 1982, by B. SUND.....