


# T.38S., R.4W., W.M.

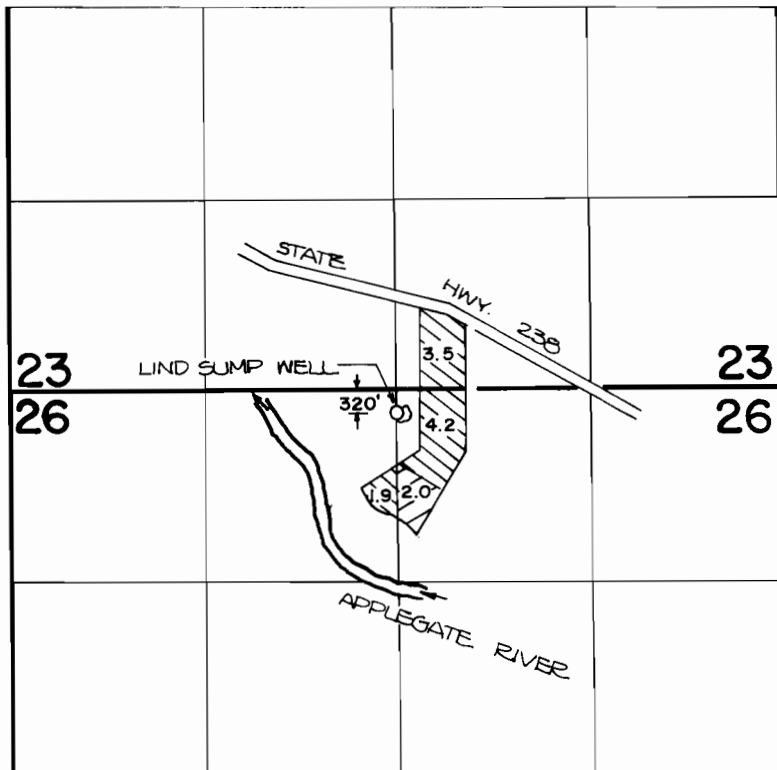

## FINAL PROOF SURVEY UNDER

Application No. ~~G-7997~~ Permit No. ~~G-7439~~  
IN NAME OF

.....**CHESTER LIND**.....

Surveyed ~~APR. 1~~ 1982, by ~~B. SUND~~.....