


T.35 S., R.2 W., W.M.

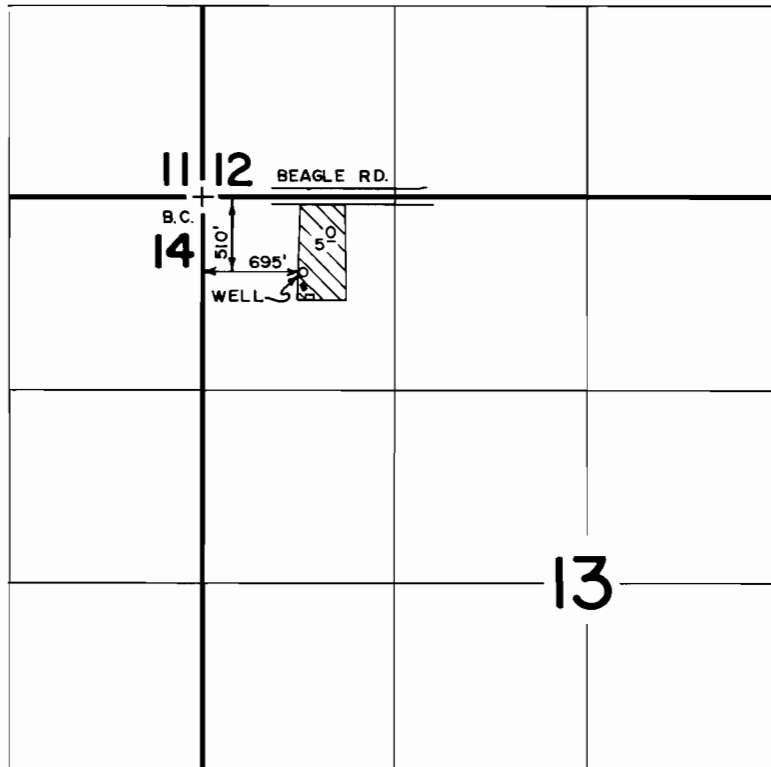

FINAL PROOF SURVEY
UNDER

Application No. **G-8843** Permit No. **G-8274**...
IN NAME OF

GREGG L. &/or GERRY L. RADFORD

Surveyed **JULY 14, 1982**, by **B. SUZIE JAMES**

SCALE: **4" = 1 MILE**