


T.38S. R.4W. W.M.

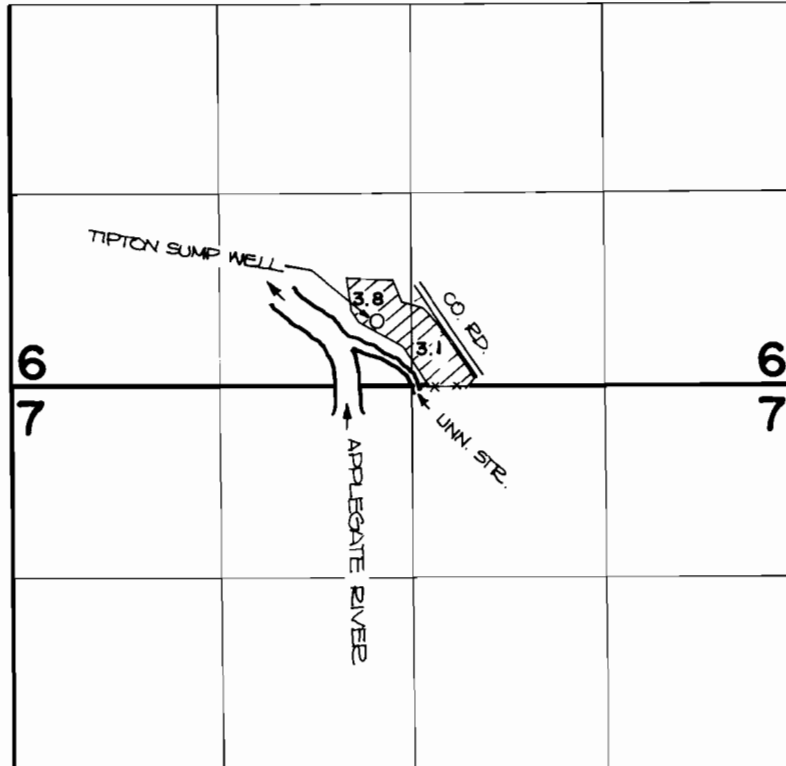

SUMP WELL IS LOCATED 420' N. AND 290' W. FROM THE S. 1/4 CORNER OF SECTION 6.

FINAL PROOF SURVEY
UNDER

Application No. ~~G-8966~~ Permit No. ~~G-8347~~.....
IN NAME OF

RALPH...AND/OR...CHARLOTTE...H...TIPTON

Surveyed APRIL.22. 1982., by ...B....SUND.....