


T. 35 S., R. 2 W., W.M.
SEC. 12

SW 1/4 NE 1/4

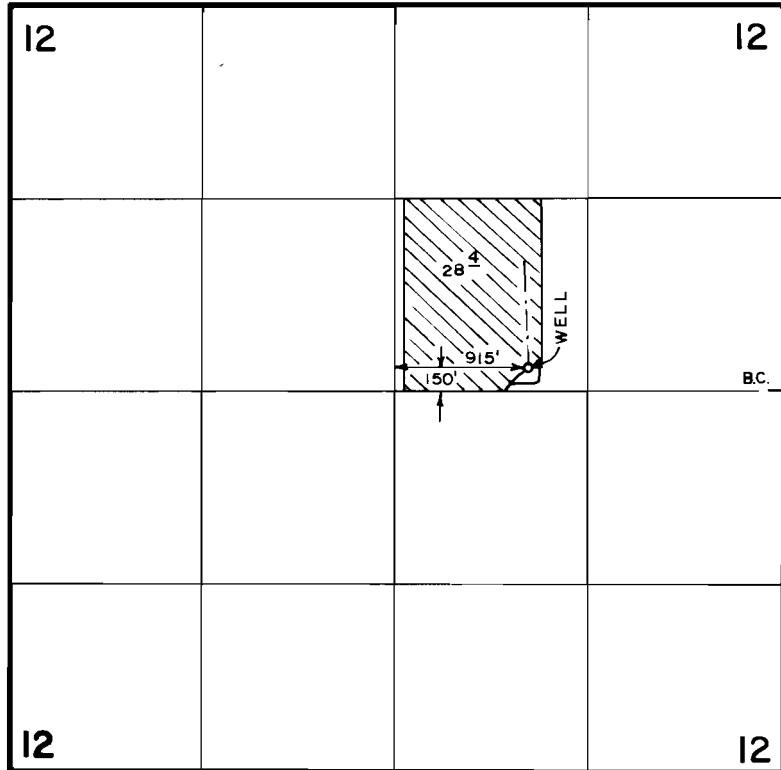

FINAL PROOF SURVEY
UNDER

Application No. G-10198 Permit No. G-9248
IN NAME OF

CHARLES B. &/or WILLIE J. ROBBINS, II

Surveyed JULY 14 19 82, by B. SUZIE JAMES

SCALE: 4" = 1 MILE