


T. 39 S., R. 1 E., W. M.

SE 1/4 NW 1/4

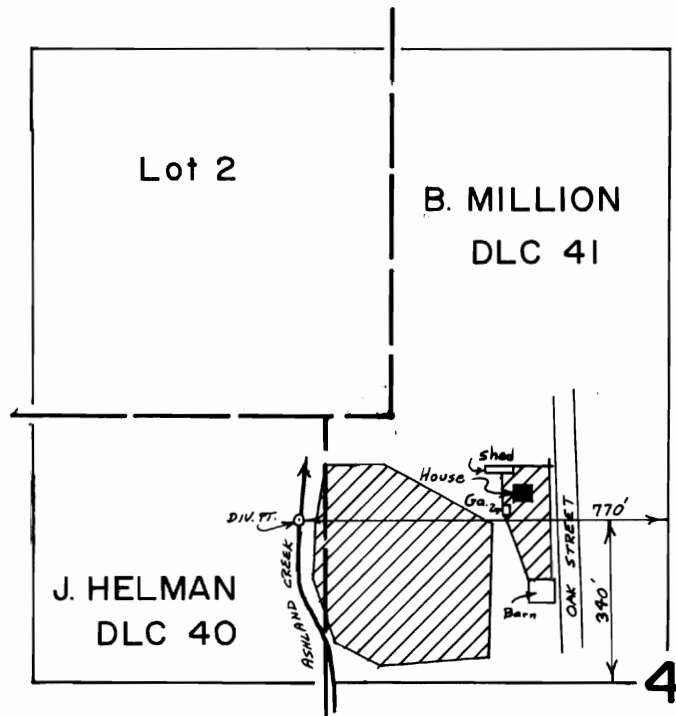

Scale : 1" = 400'

FINAL PROOF SURVEY
UNDER

Transfer no. 3900

Application No. Permit No.
IN NAME OF

... MARGARET ELANOR HAYWOOD

Surveyed JUNE 11, 1979, by B. SUND