


T.34S., R.5 W., W.M.

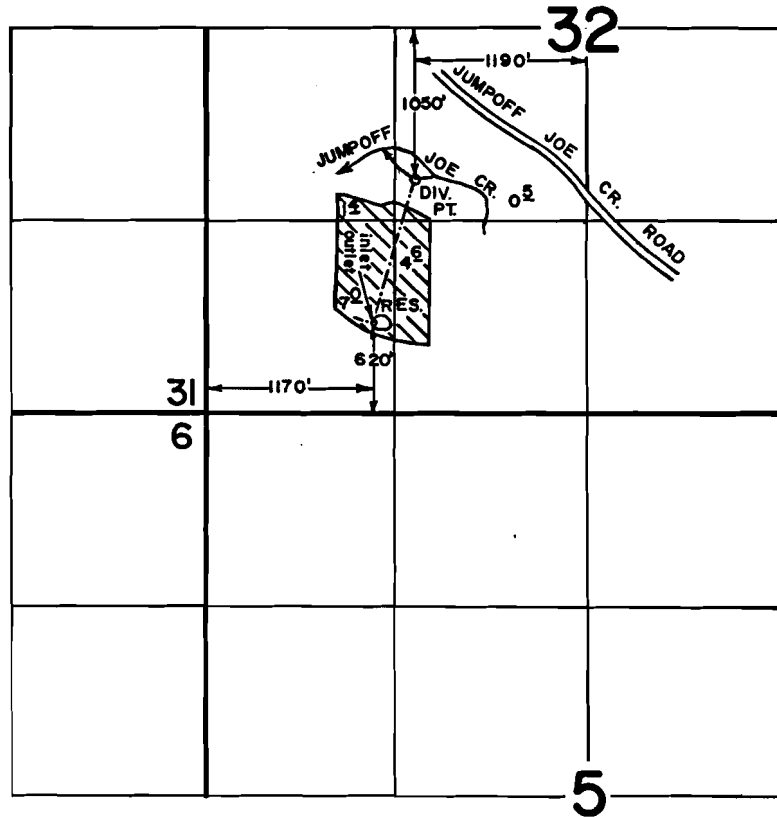

FINAL PROOF SURVEY
UNDER

R-55636 R-6748

Application No. 55637 Permit No. 42543
IN NAME OF

.....Dale and Sharelyn Pugh.....

Surveyed SEPT. 14 1982, by B. S. JAMES.....

SCALE: 4" = 1 MILE