


T.34S., R.5 W., W.M.

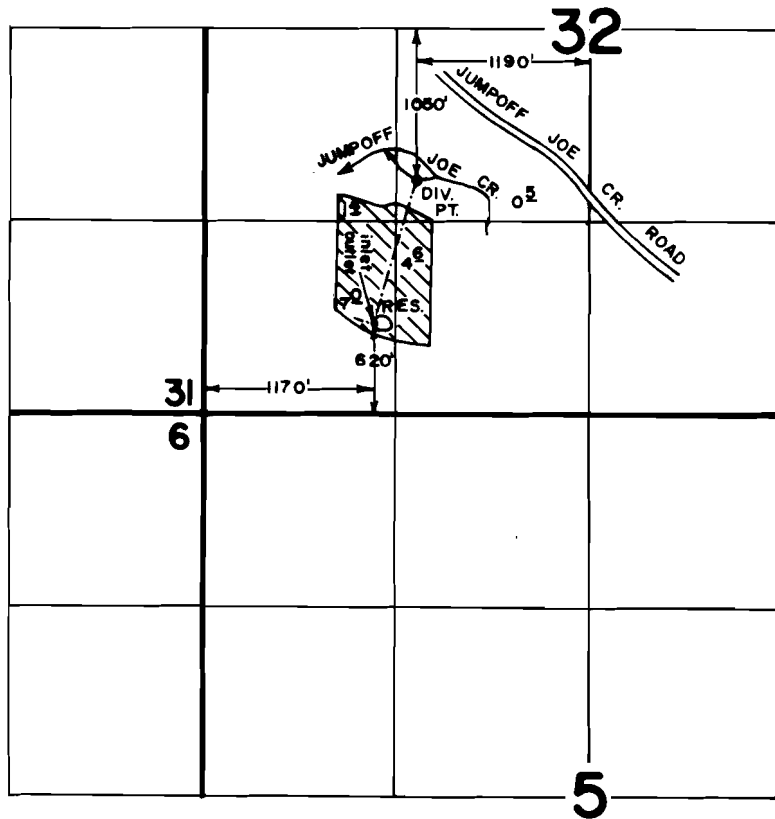

**FINAL PROOF SURVEY**  
UNDER

R-55636

R-6748

Application No. 55637 Permit No. 42543

IN NAME OF

Dale and Sherelyn Pugh

Surveyed SEPT. 14 1982, by B. S. JAMES

SCALE: 4" = 1 MILE