


T. 39 S., R. 8 W., W.M.

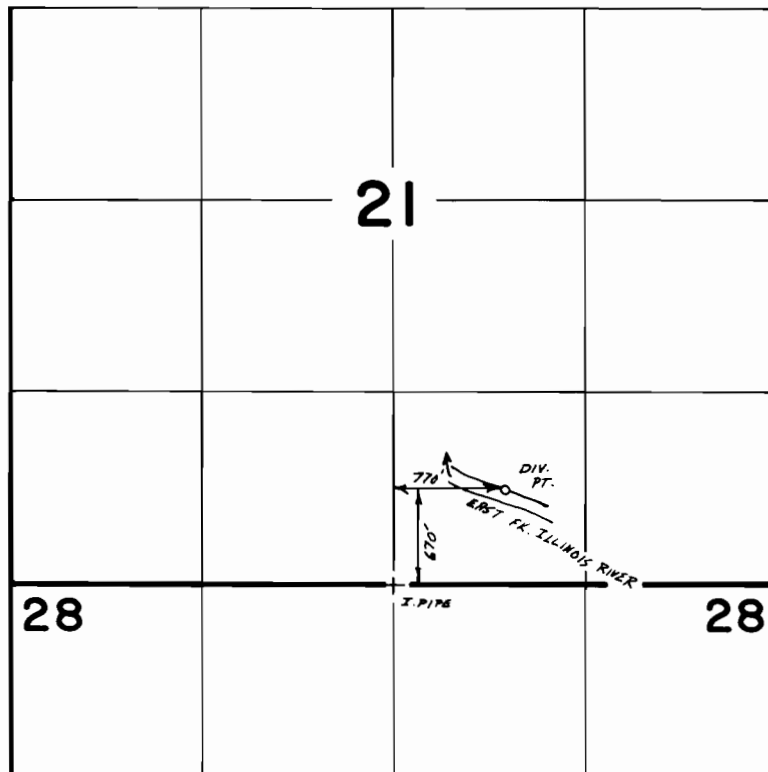

Scale 4" = 1 Mile

FINAL PROOF SURVEY
UNDER

Application No. **23847** Permit No. **18785**
IN NAME OF

CITY OF CAVE JUNCTION

Surveyed **Aug. 24, 1982**, by **B.R. SUND**