


T. 34S., R. 5W., W.M.

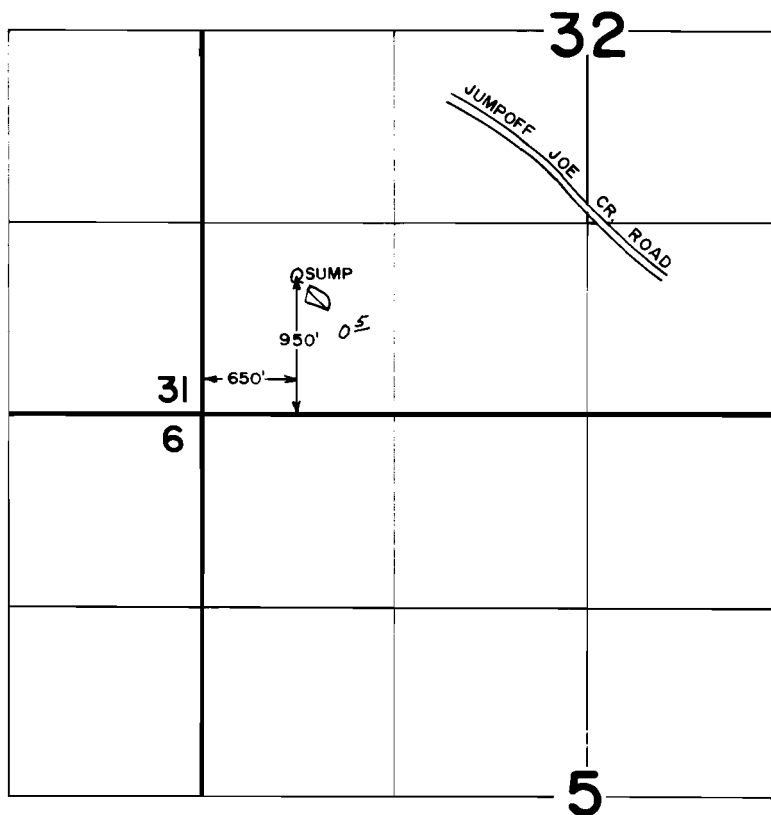

FINAL PROOF SURVEY
UNDER

Application No. G-7553 Permit No. G-7021
IN NAME OF

LEON B. DAVIS

Surveyed SEPT. 14 1982, by B. S. JAMES

SCALE : 4" = 1 MILE