


T. 37 S., R. 6 W., W.M.

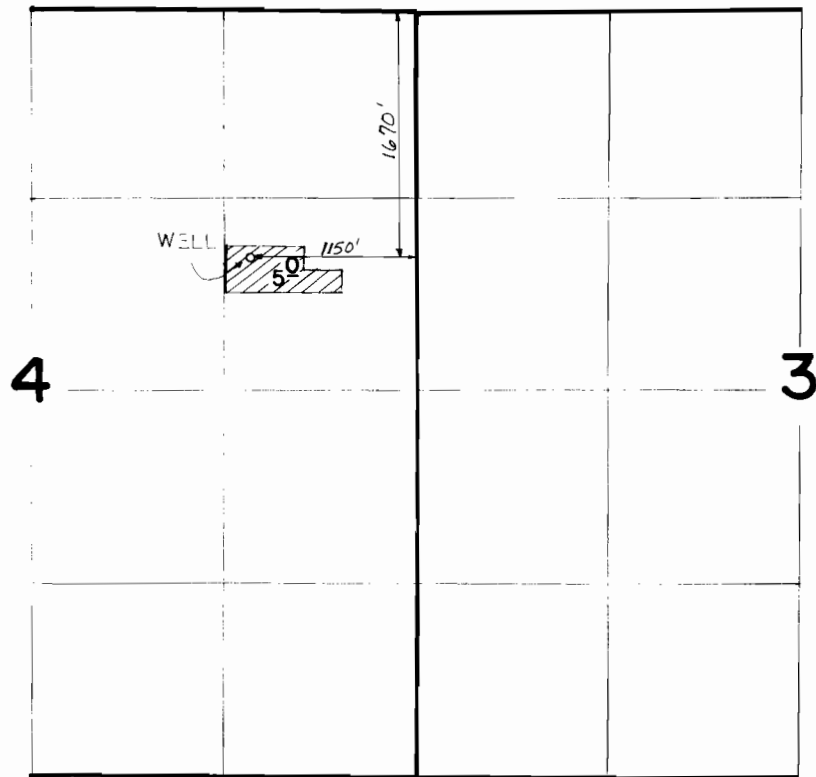

FINAL PROOF SURVEY  
UNDER

Application No. G. 8406 Permit No. G. 7857.....  
IN NAME OF

TOM E. WASHBURN

Surveyed AUG 11, 1982, by B. S. JAMES.....