



T.37 & 38 S., R.5 W., W. M.

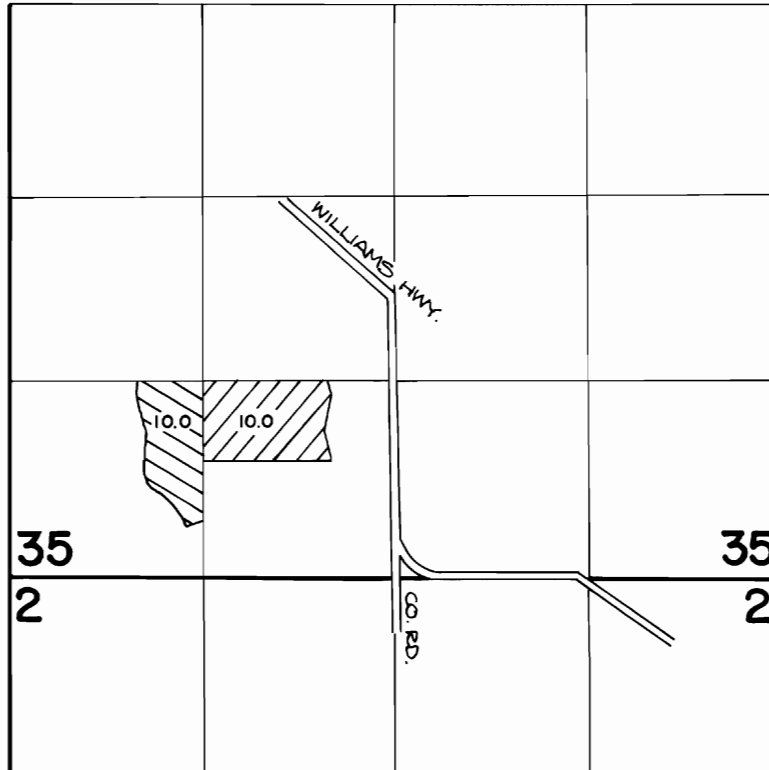

T-4017

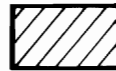

T-4018

FINAL PROOF SURVEY
UNDER

TRANSFERS NO. 4017 & 4018

IN NAME OF

.....**LYLE WOODCOCK**.....

Surveyed **AUG. 16, 1983**, by **B. JAMES**.....