


T. 6 & 7 S. R. 43 E. W. M.

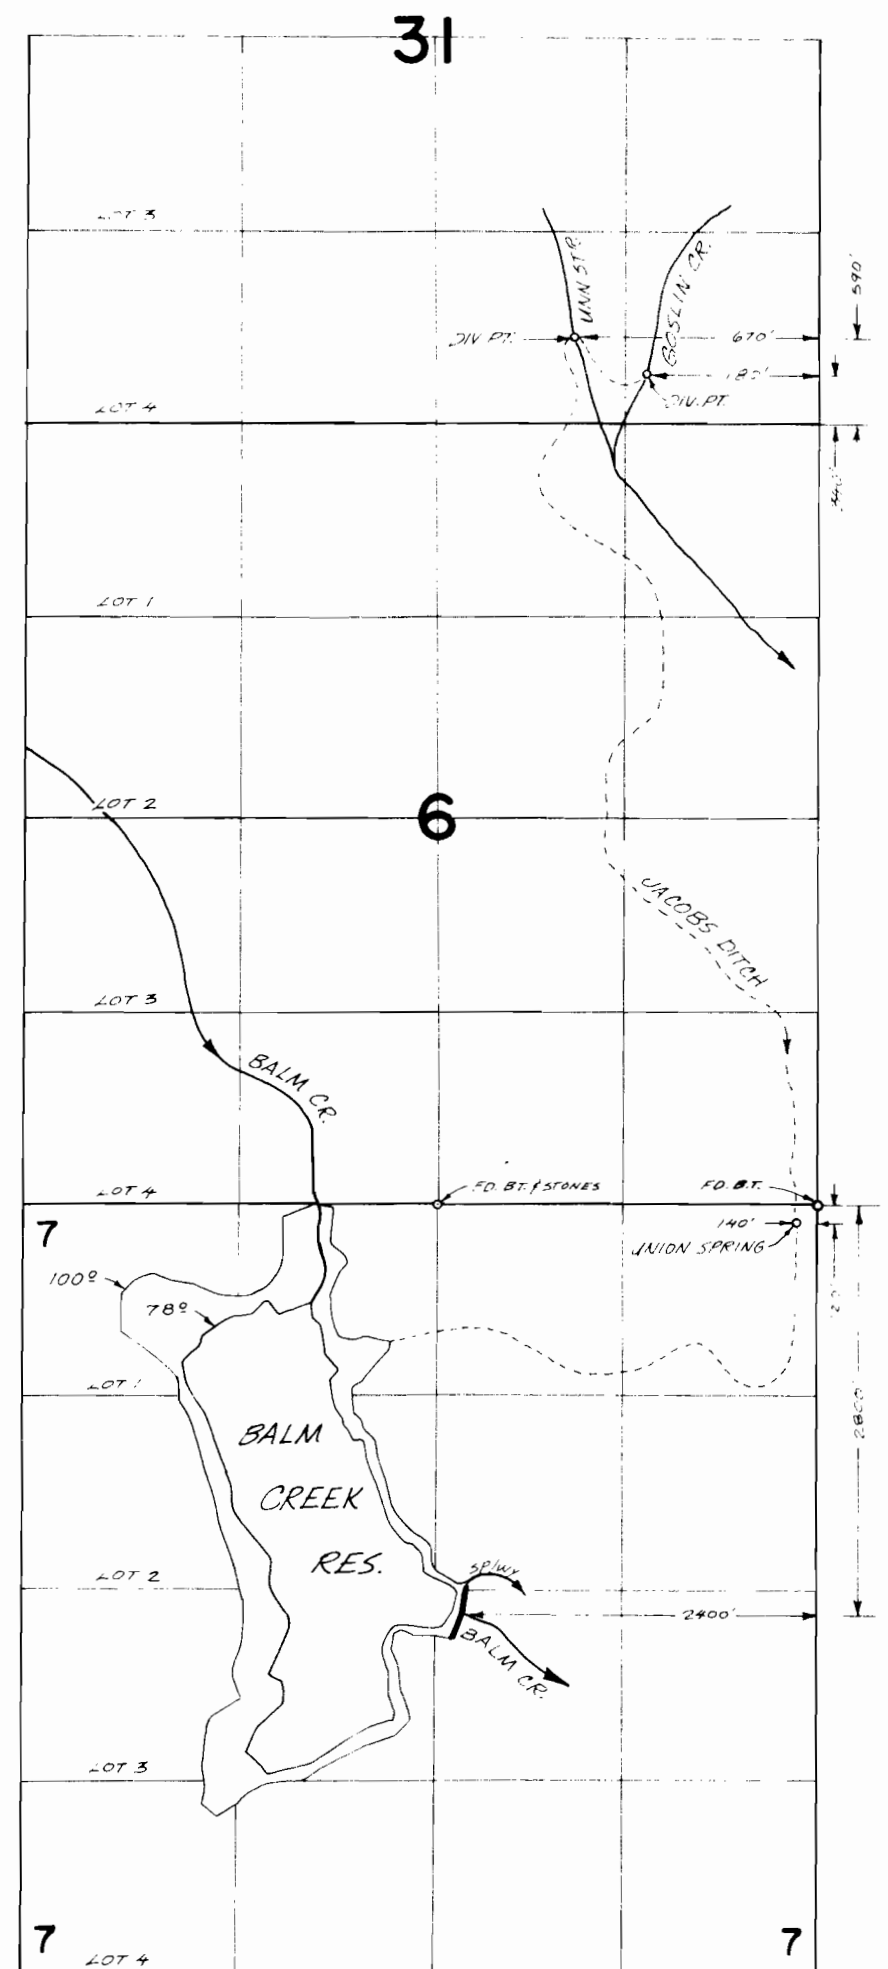

SURVEYED OCT 23 1974, BY L.M.TOLL