
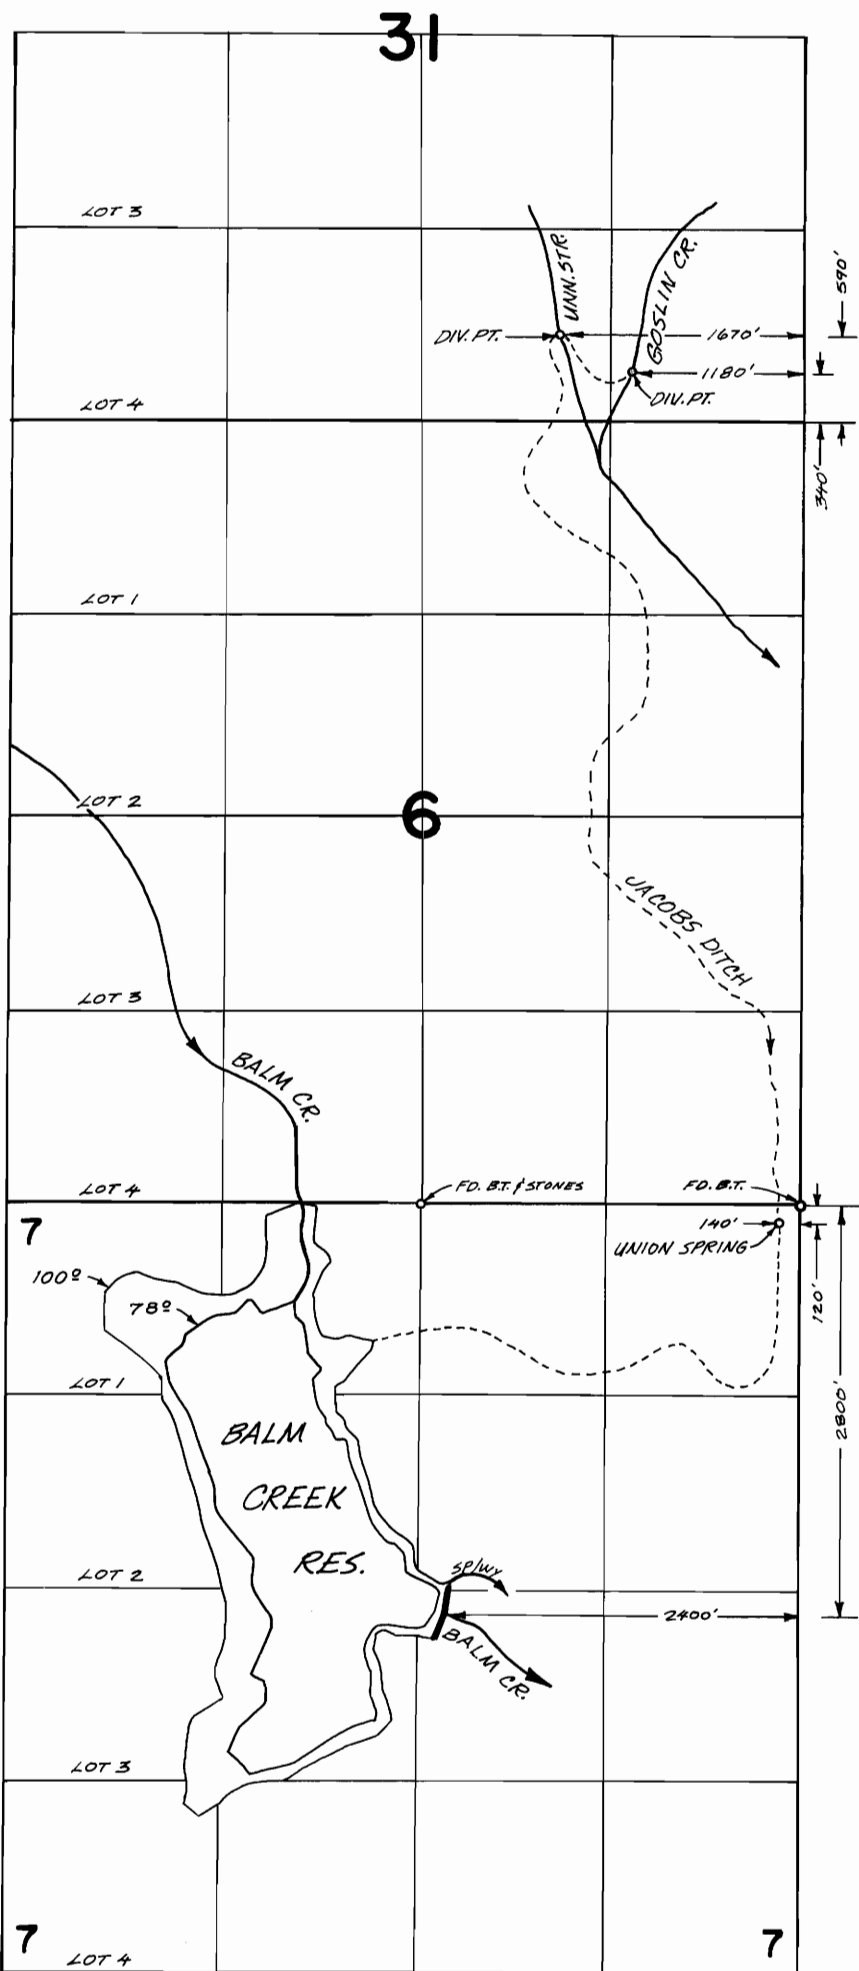


T.8S.R.42&43E.W.M.

T.6&7S.R.43E.W.M.

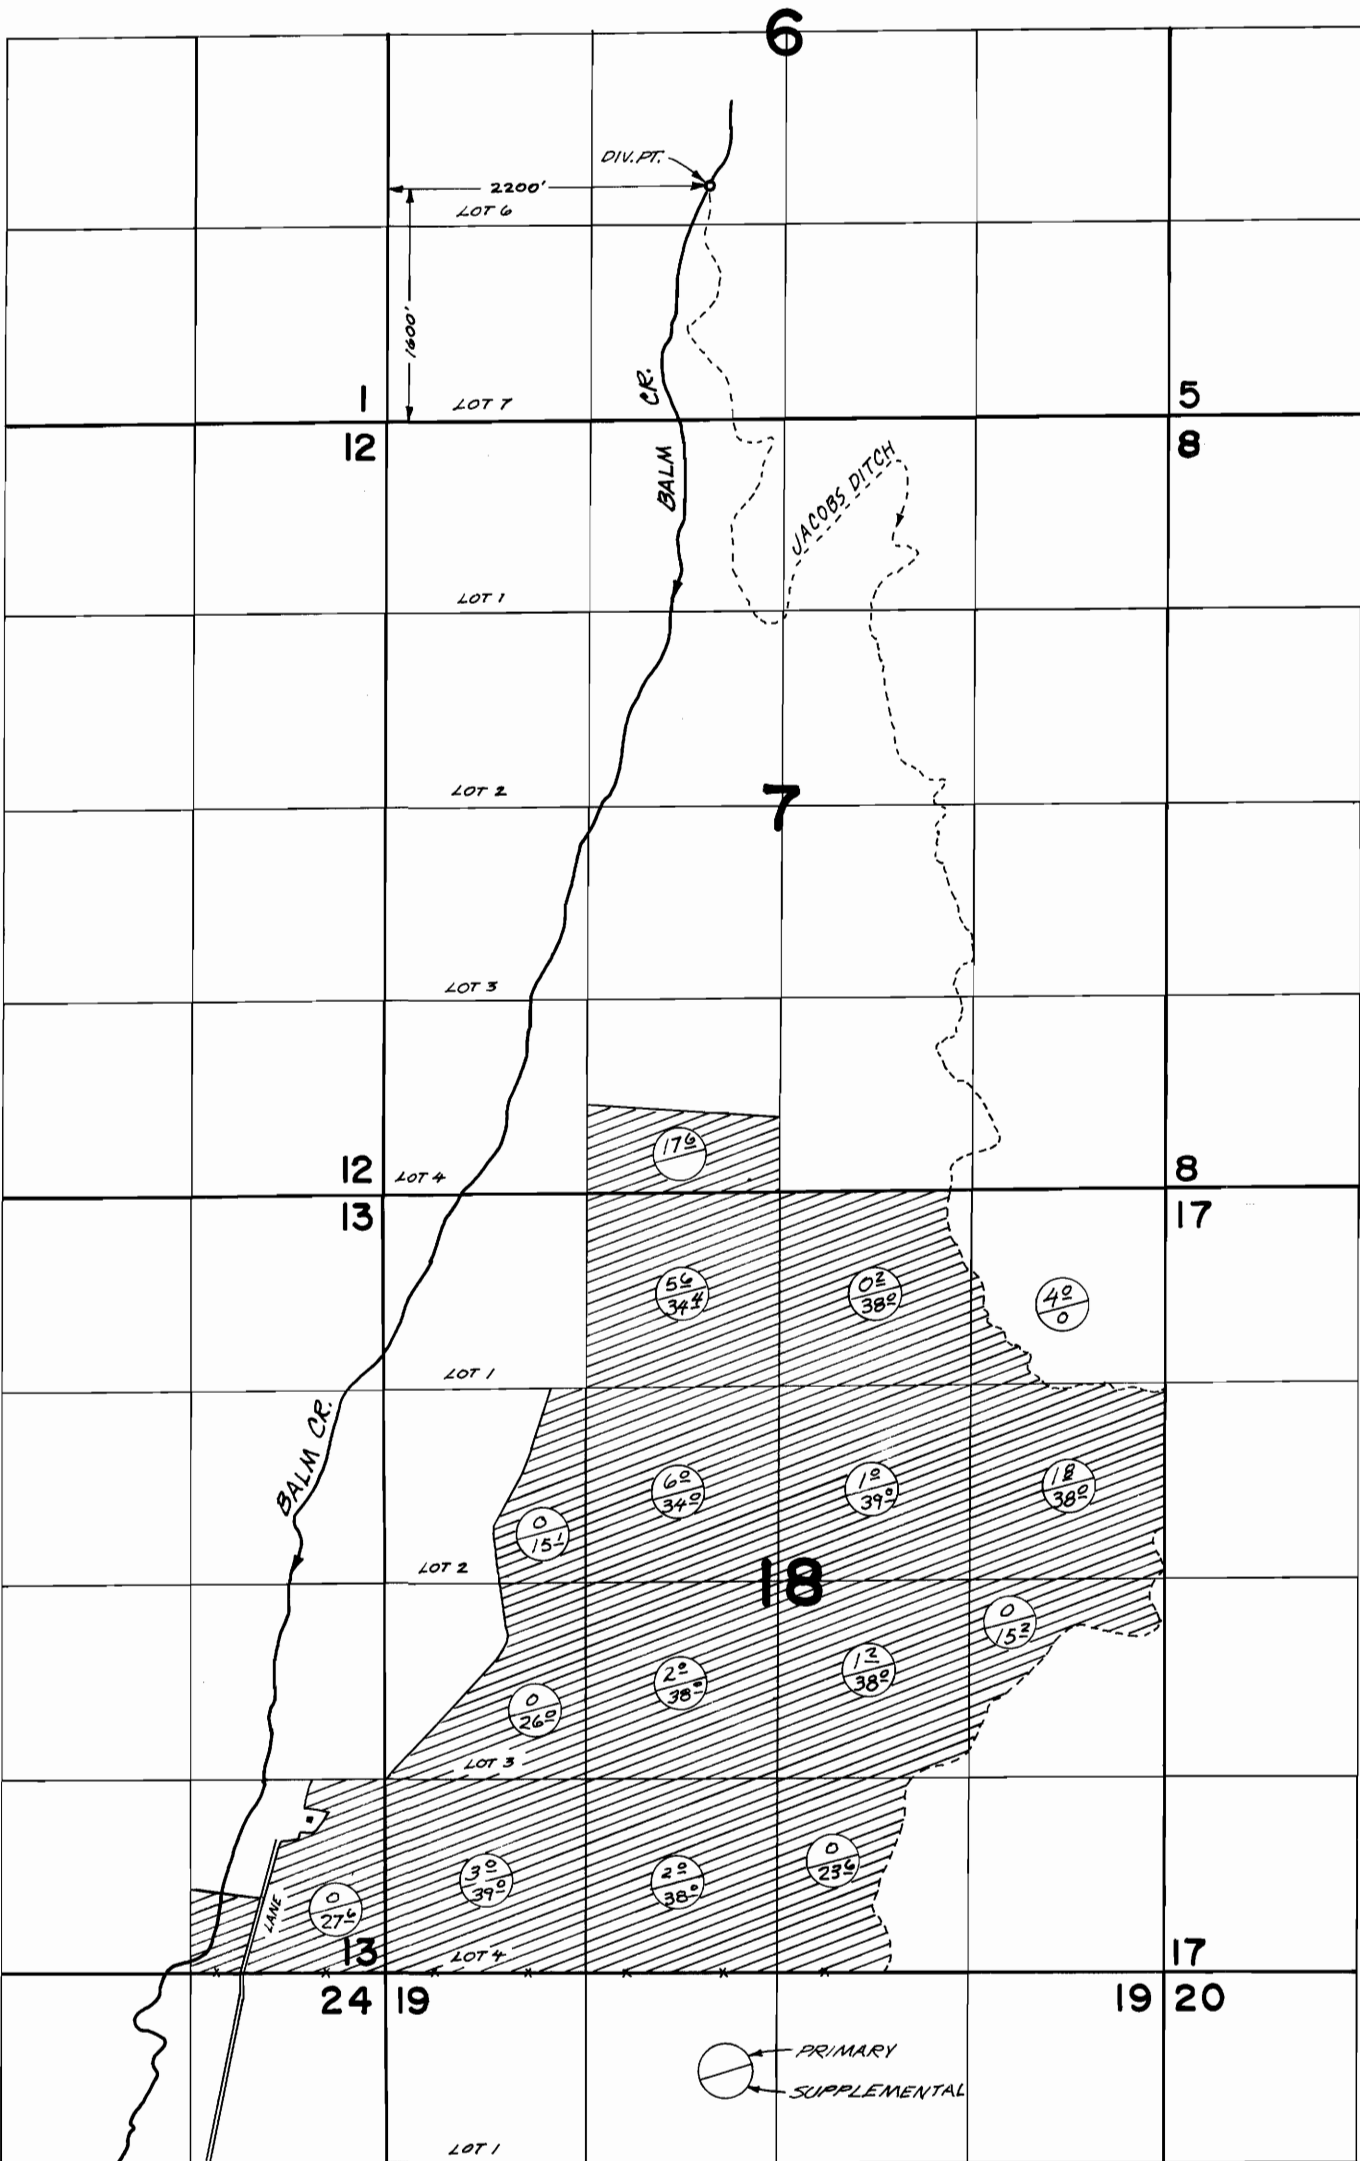

FINAL PROOF SURVEY
UNDER

R-37968 R-3679
APPLICATION NO. 37969 PERMIT NO. 29Q14
IN NAME OF

HARRY H. JACOBS & SONS
SURVEYED OCT. 23, 1974, BY L.M. IOLL