


TIIS. R7W. WM.

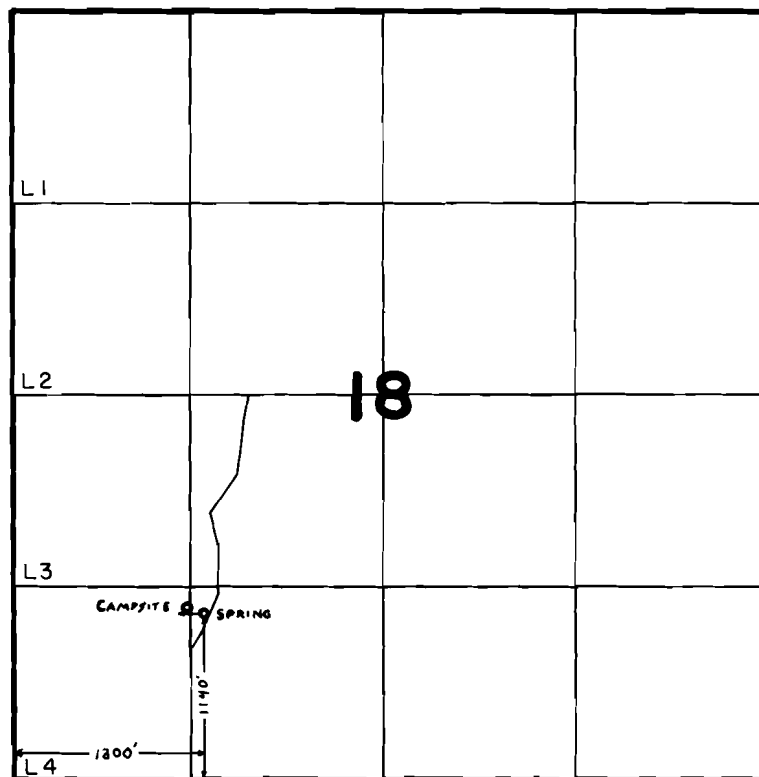

FINAL PROOF SURVEY
UNDER

Application No. 58247 Permit No. 43862
IN NAME OF

STARKER FORESTS INC.

Surveyed May 3 1979, by C. L. HUGHES