


T.5S., R.1E., W.M.

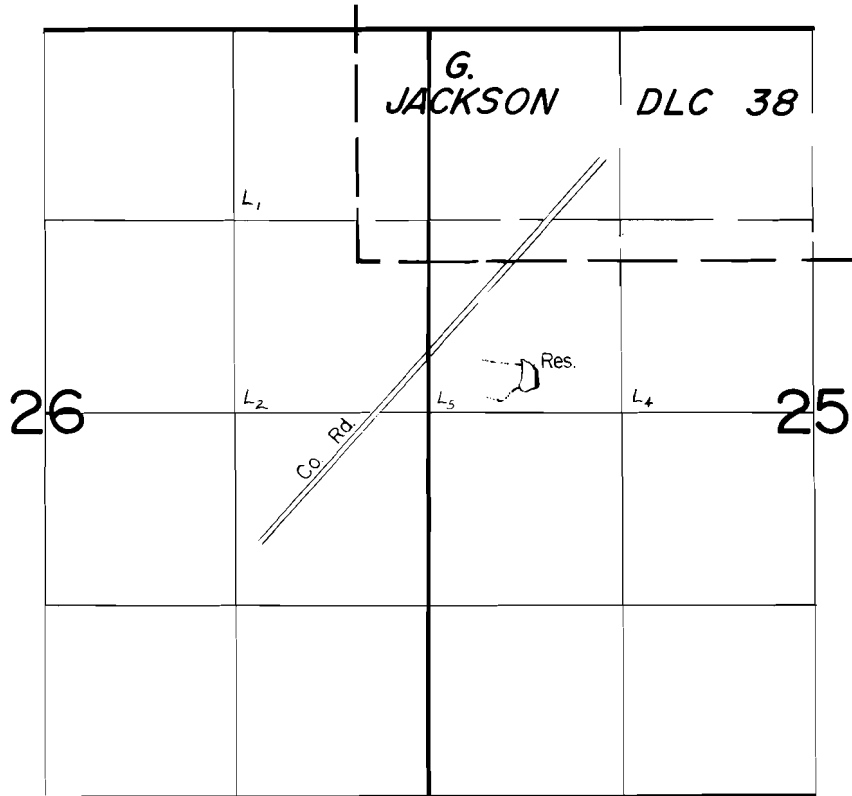

Scale: 1" = 1320'

FINAL PROOF SURVEY

UNDER

Application No. R-60427 Permit No. R-8150....
IN NAME OF

CLIFFORD D. RAY

Surveyed JULY...16.. 1985., by J. Warren.....

41005-278-144A
PTS-1985 A
T.M.W.