


# T.4S.R.IE.W.M.

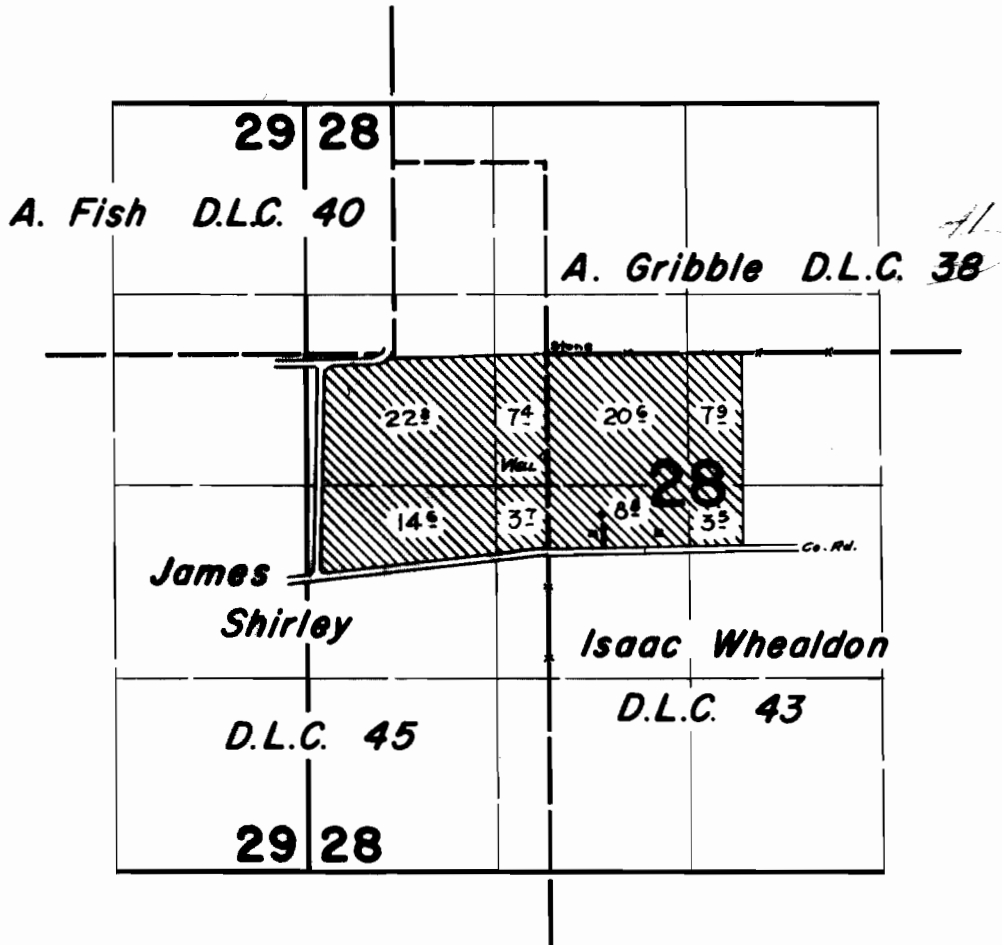

## FINAL PROOF SURVEY UNDER

Application No. G-2330 Permit No. G-2153  
IN NAME OF

CLYDE C. BACKSEN

Surveyed April 2, 1963, by *R. Jackson*