


T. 6 S., R. 1 E., W. M.

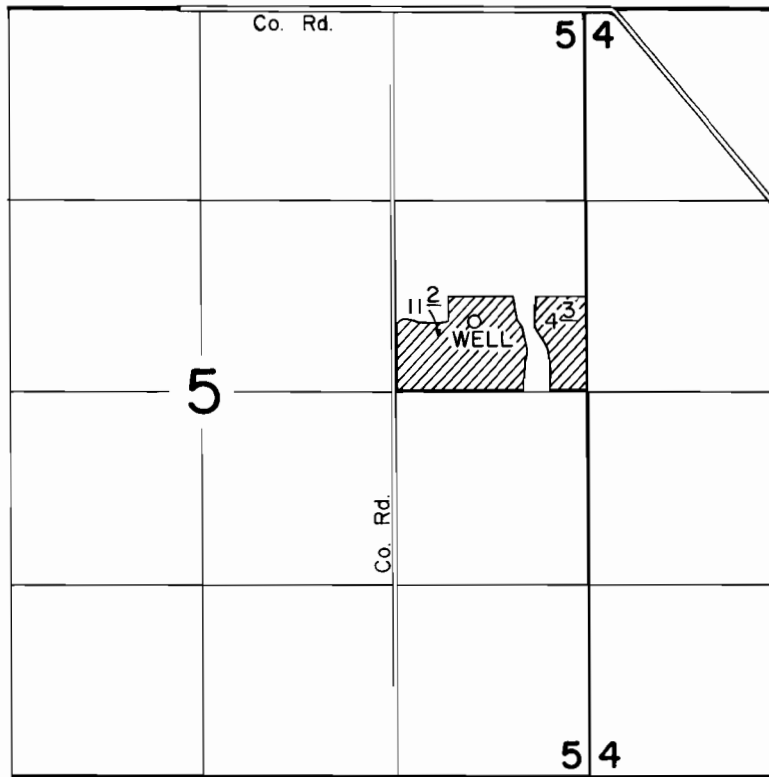

WELL LOC: 480' N. & 780' W. FROM THE E. 1/4 CORNER SEC. 5

SCALE: 1" = 1320'

FINAL PROOF SURVEY

UNDER

Application No. G-9457 Permit No. G-8670
IN NAME OF

ALEXIE BERDOGIN

Surveyed JUNE 28, 1985, by T. WARREN