



T.16S.R.10E.W.M.

6-55513

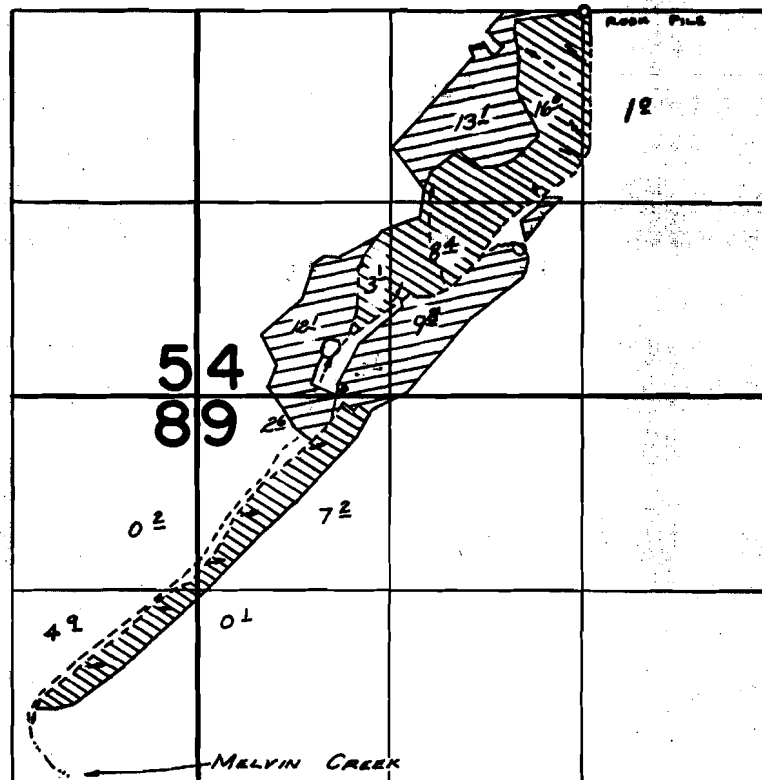

T.16S.R.9E.W.M.

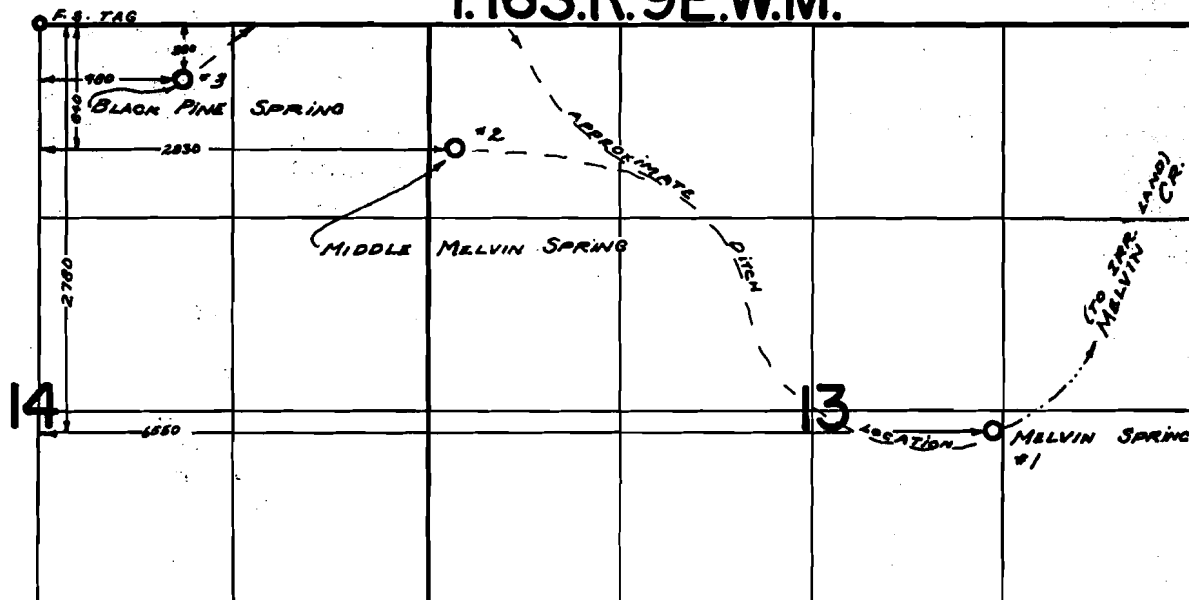

FINAL PROOF SURVEY
UNDER

Application No. 49952 Permit No. 37894
IN NAME OF

STEPHEN EBERLY THOMPSON JR.

Surveyed Oct. 25, 1968
Oct. 2, 1969, by D. Buell
May 22, 1979
May 23, 1980 L. H. Newlin



cert. 55513
this is suppl.
see Cert 38807 for
1959 Primary

11-1980-A 37894