


P-31097

- 55514

T. 12S. R. 27E. W. M.

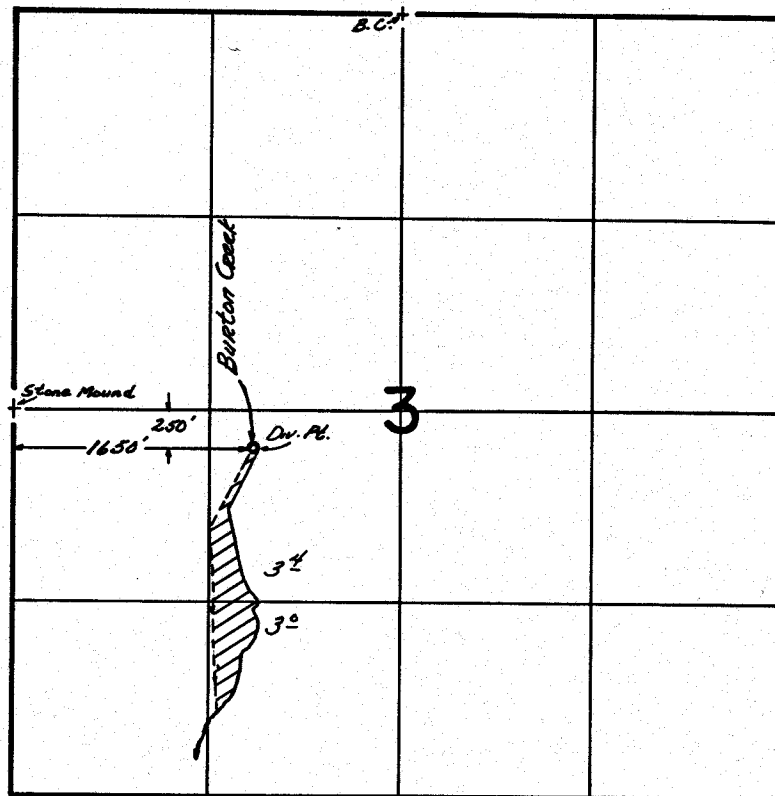

FINAL PROOF SURVEY
UNDER

Application No. 41674. Permit No. 31097.....
IN NAME OF

.....**GEORGE MACKAY**.....

Surveyed Sept. 14. 1979., by S.C. BROWN.....

PTS-1979-A-622