


27318
55516 T5806
T8375

T.26 S.R.15 E.W.M.

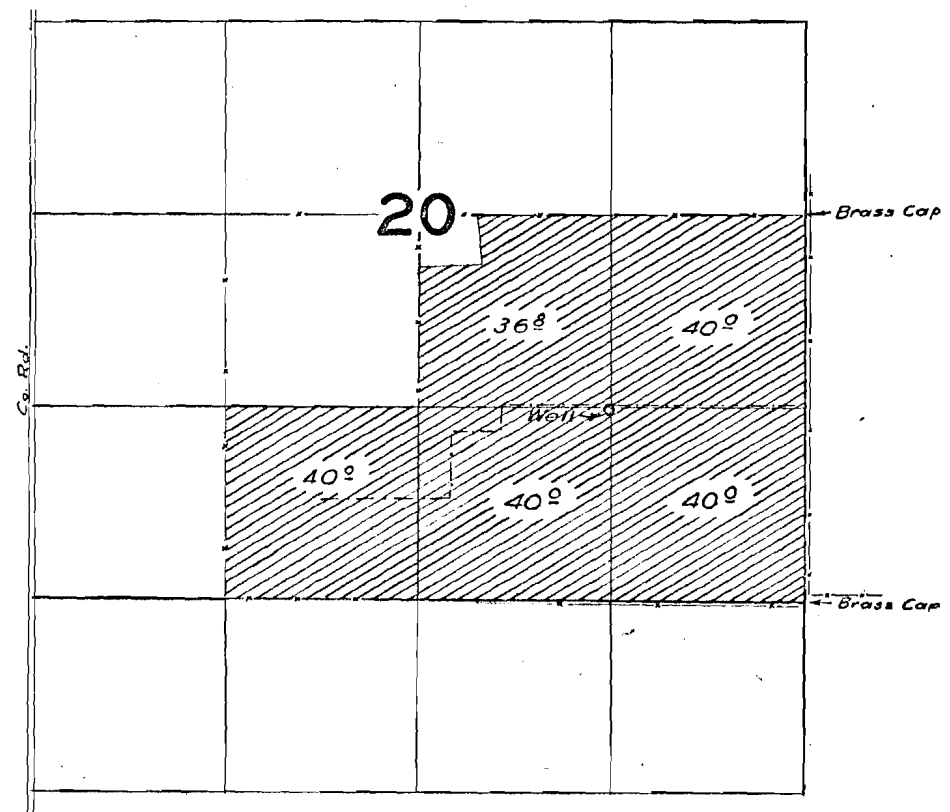

FINAL PROOF SURVEY UNDER

Application No. G-465 Permit No. G-370
IN NAME OF

HUGH WAHL

Surveyed 11 May 1959, by M. B. Bish